


T. 36 S., R. 1 W., W. M.

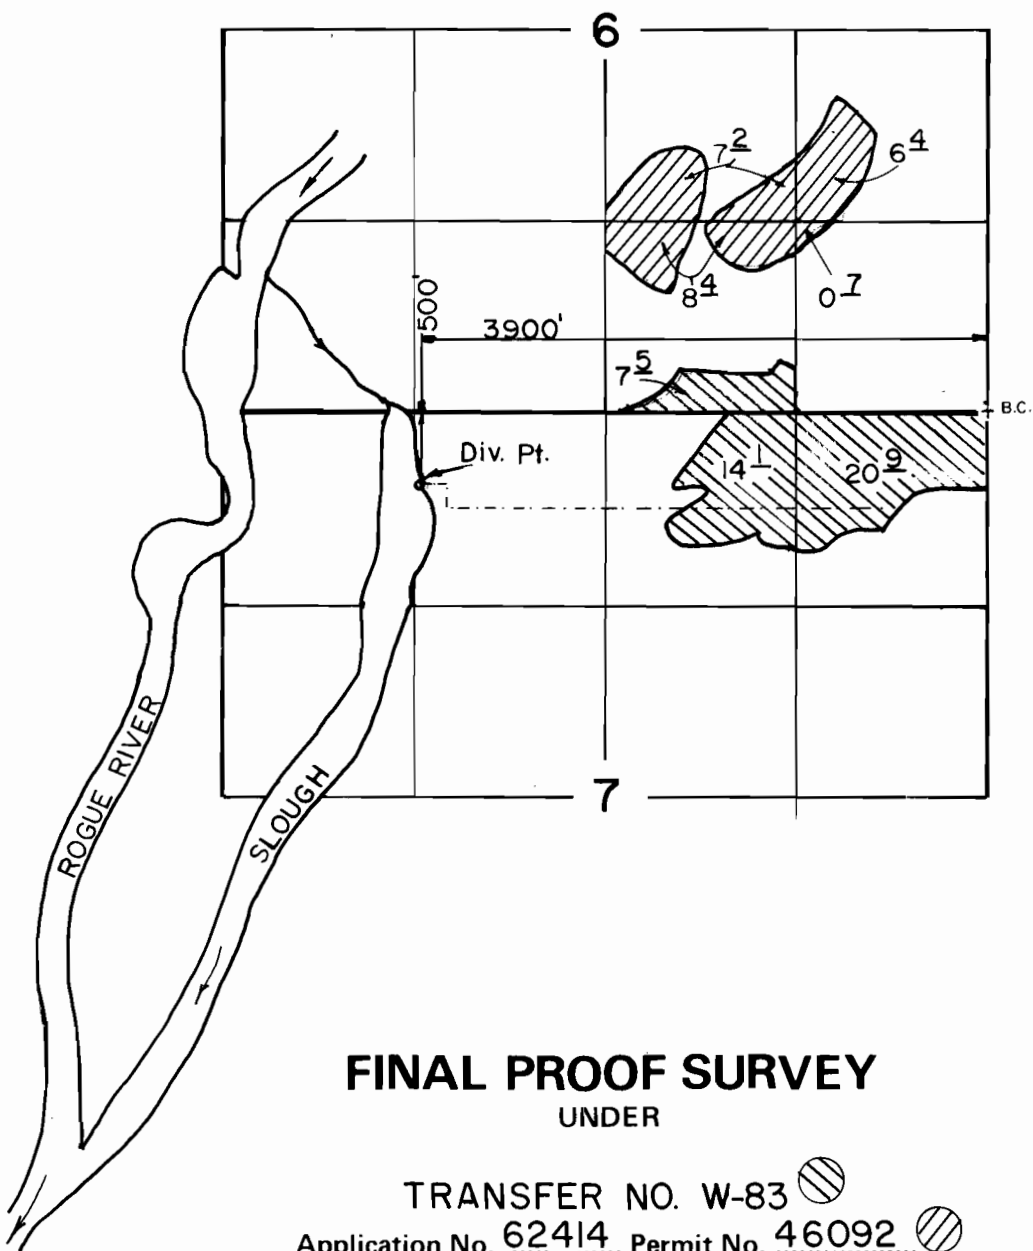

FINAL PROOF SURVEY
UNDER

TRANSFER NO. W-83

Application No. 62414 Permit No. 46092

IN NAME OF

SOUTHERN OREGON TALLOW CO.

Surveyed FEB. 22. 19.88, by L.M. JOACHIMS