


T. 39 S., R. 3 W., W. M.

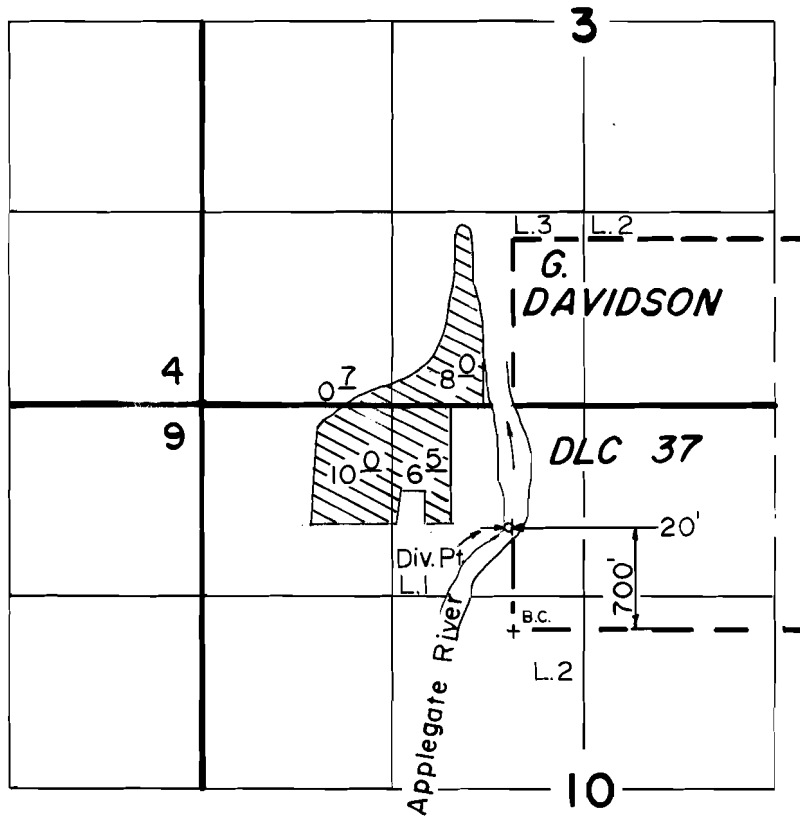

Scale:
1" = 1320'

FINAL PROOF SURVEY
UNDER

Application No. 62955 Permit No. 46627...
IN NAME OF

NORTON L. SMITH

Surveyed FEB. 11 1988, by B. S. JAMES