



T. 39 S., R. 3 W., W. M.

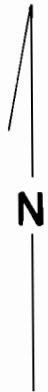

Scale:  
1" = 1320'

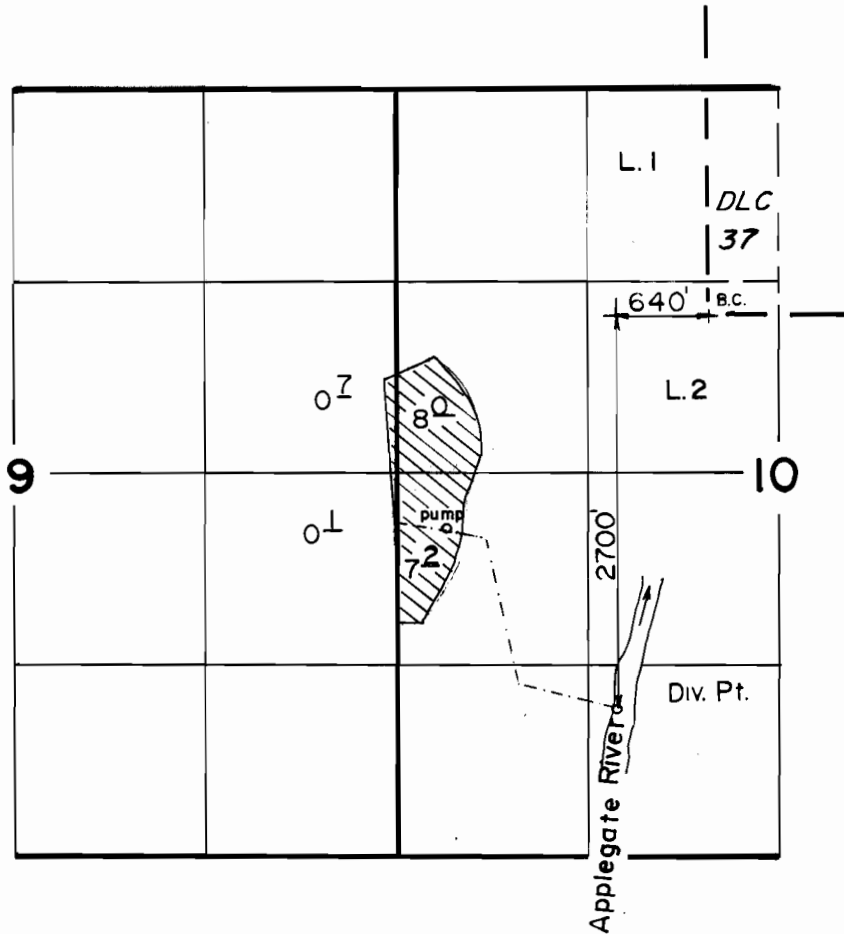

**FINAL PROOF SURVEY**  
UNDER

65163                      48062  
Application No. 65164 Permit No. 48063  
IN NAME OF

.....NORTON L. SMITH.....

Surveyed FEB. 11, 1988, by B. S. JAMES.