



T. 39 S., R. 3 W., W. M.

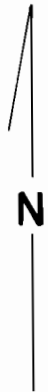

Scale:
1" = 1320'

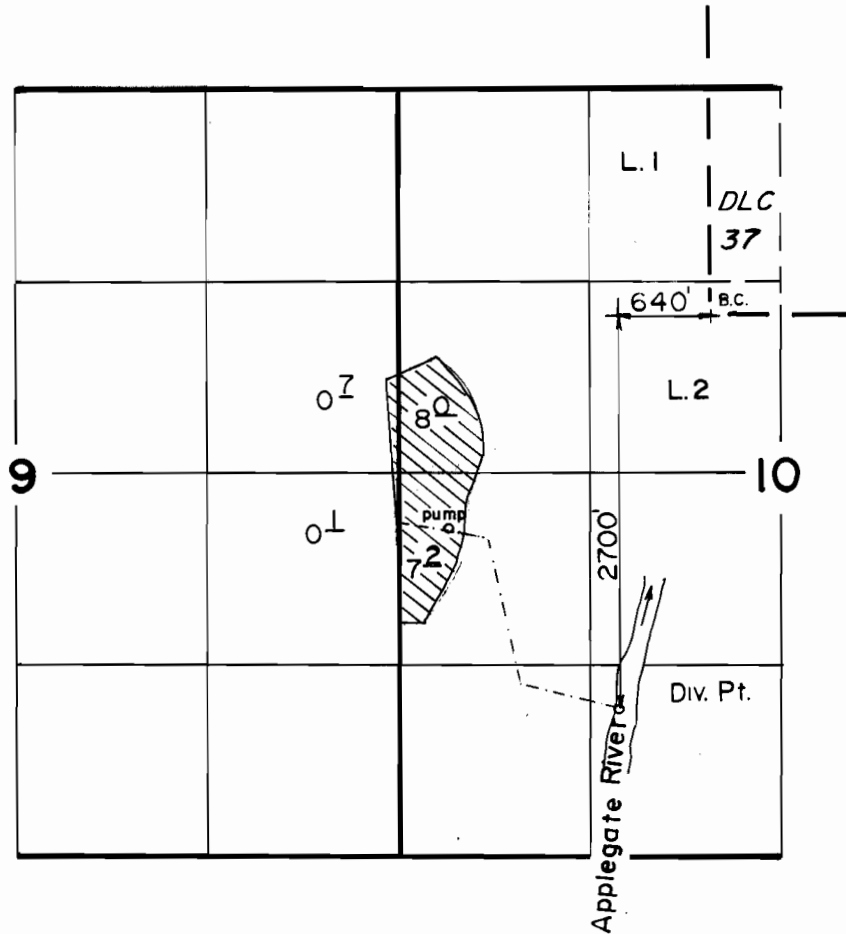

FINAL PROOF SURVEY
UNDER

65163 48062
Application No. 65164 Permit No. 48063
IN NAME OF

.....NORTON L. SMITH.....

Surveyed FEB. 11, 1988, by B. S. JAMES.