
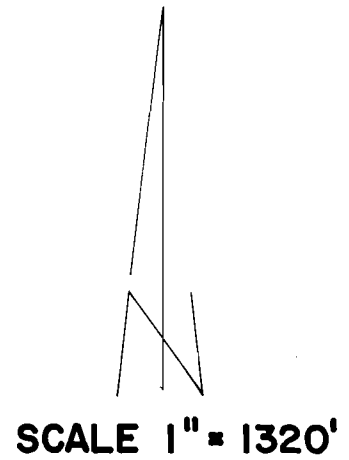


T. 2N., R. 16E., W. M.

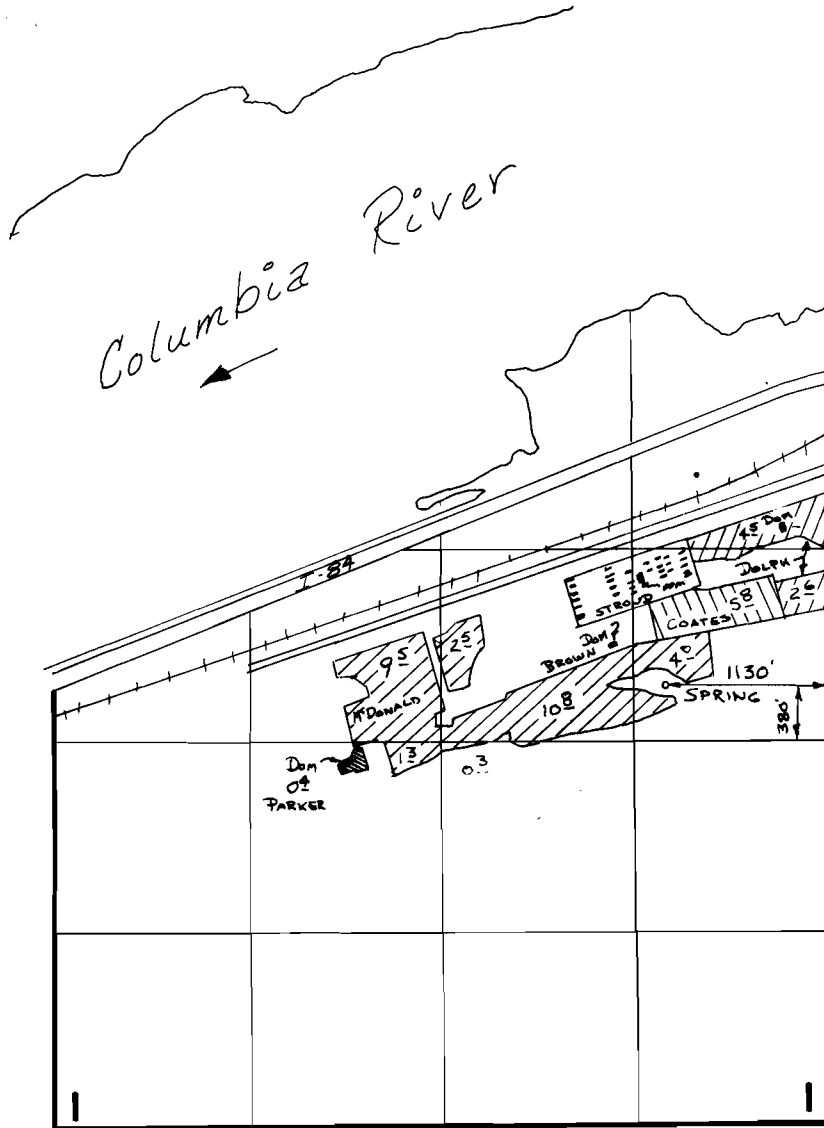

FINAL PROOF SURVEY
UNDER

Application No. **63118**..... Permit No. **47609**.....
IN NAME OF

MURRAY SPRING WATER ASSOC.

Surveyed *11-17*..... 19*87*, by *V.L. Church*.....