
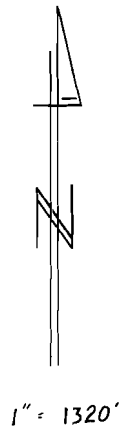


T3S, RIW, WM

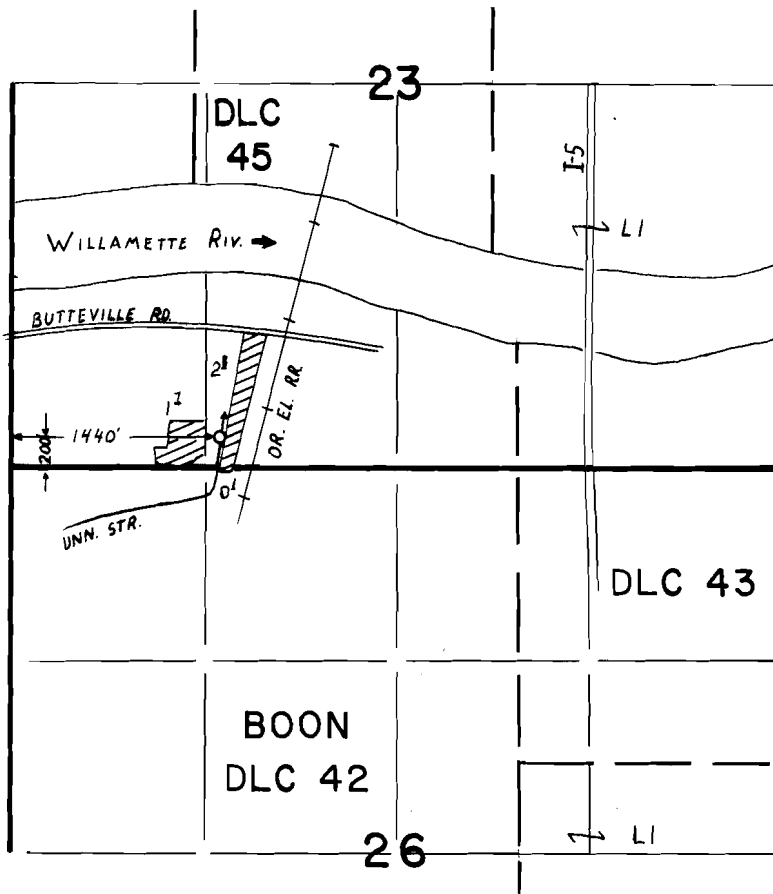

FINAL PROOF SURVEY UNDER

Application No. 632.35.. Permit No. 47.759.....
IN NAME OF

ESTATE OF JAMES W. BERNERT

Surveyed JULY 23, 1987., by T.M. WARREN...

RWK
DFK 2LL 3