Lake Shore Development DBA Blue Lake Resort

Sec 27 T135 R8E WM

Scale 8" = 1 mile
or 1" = 660'

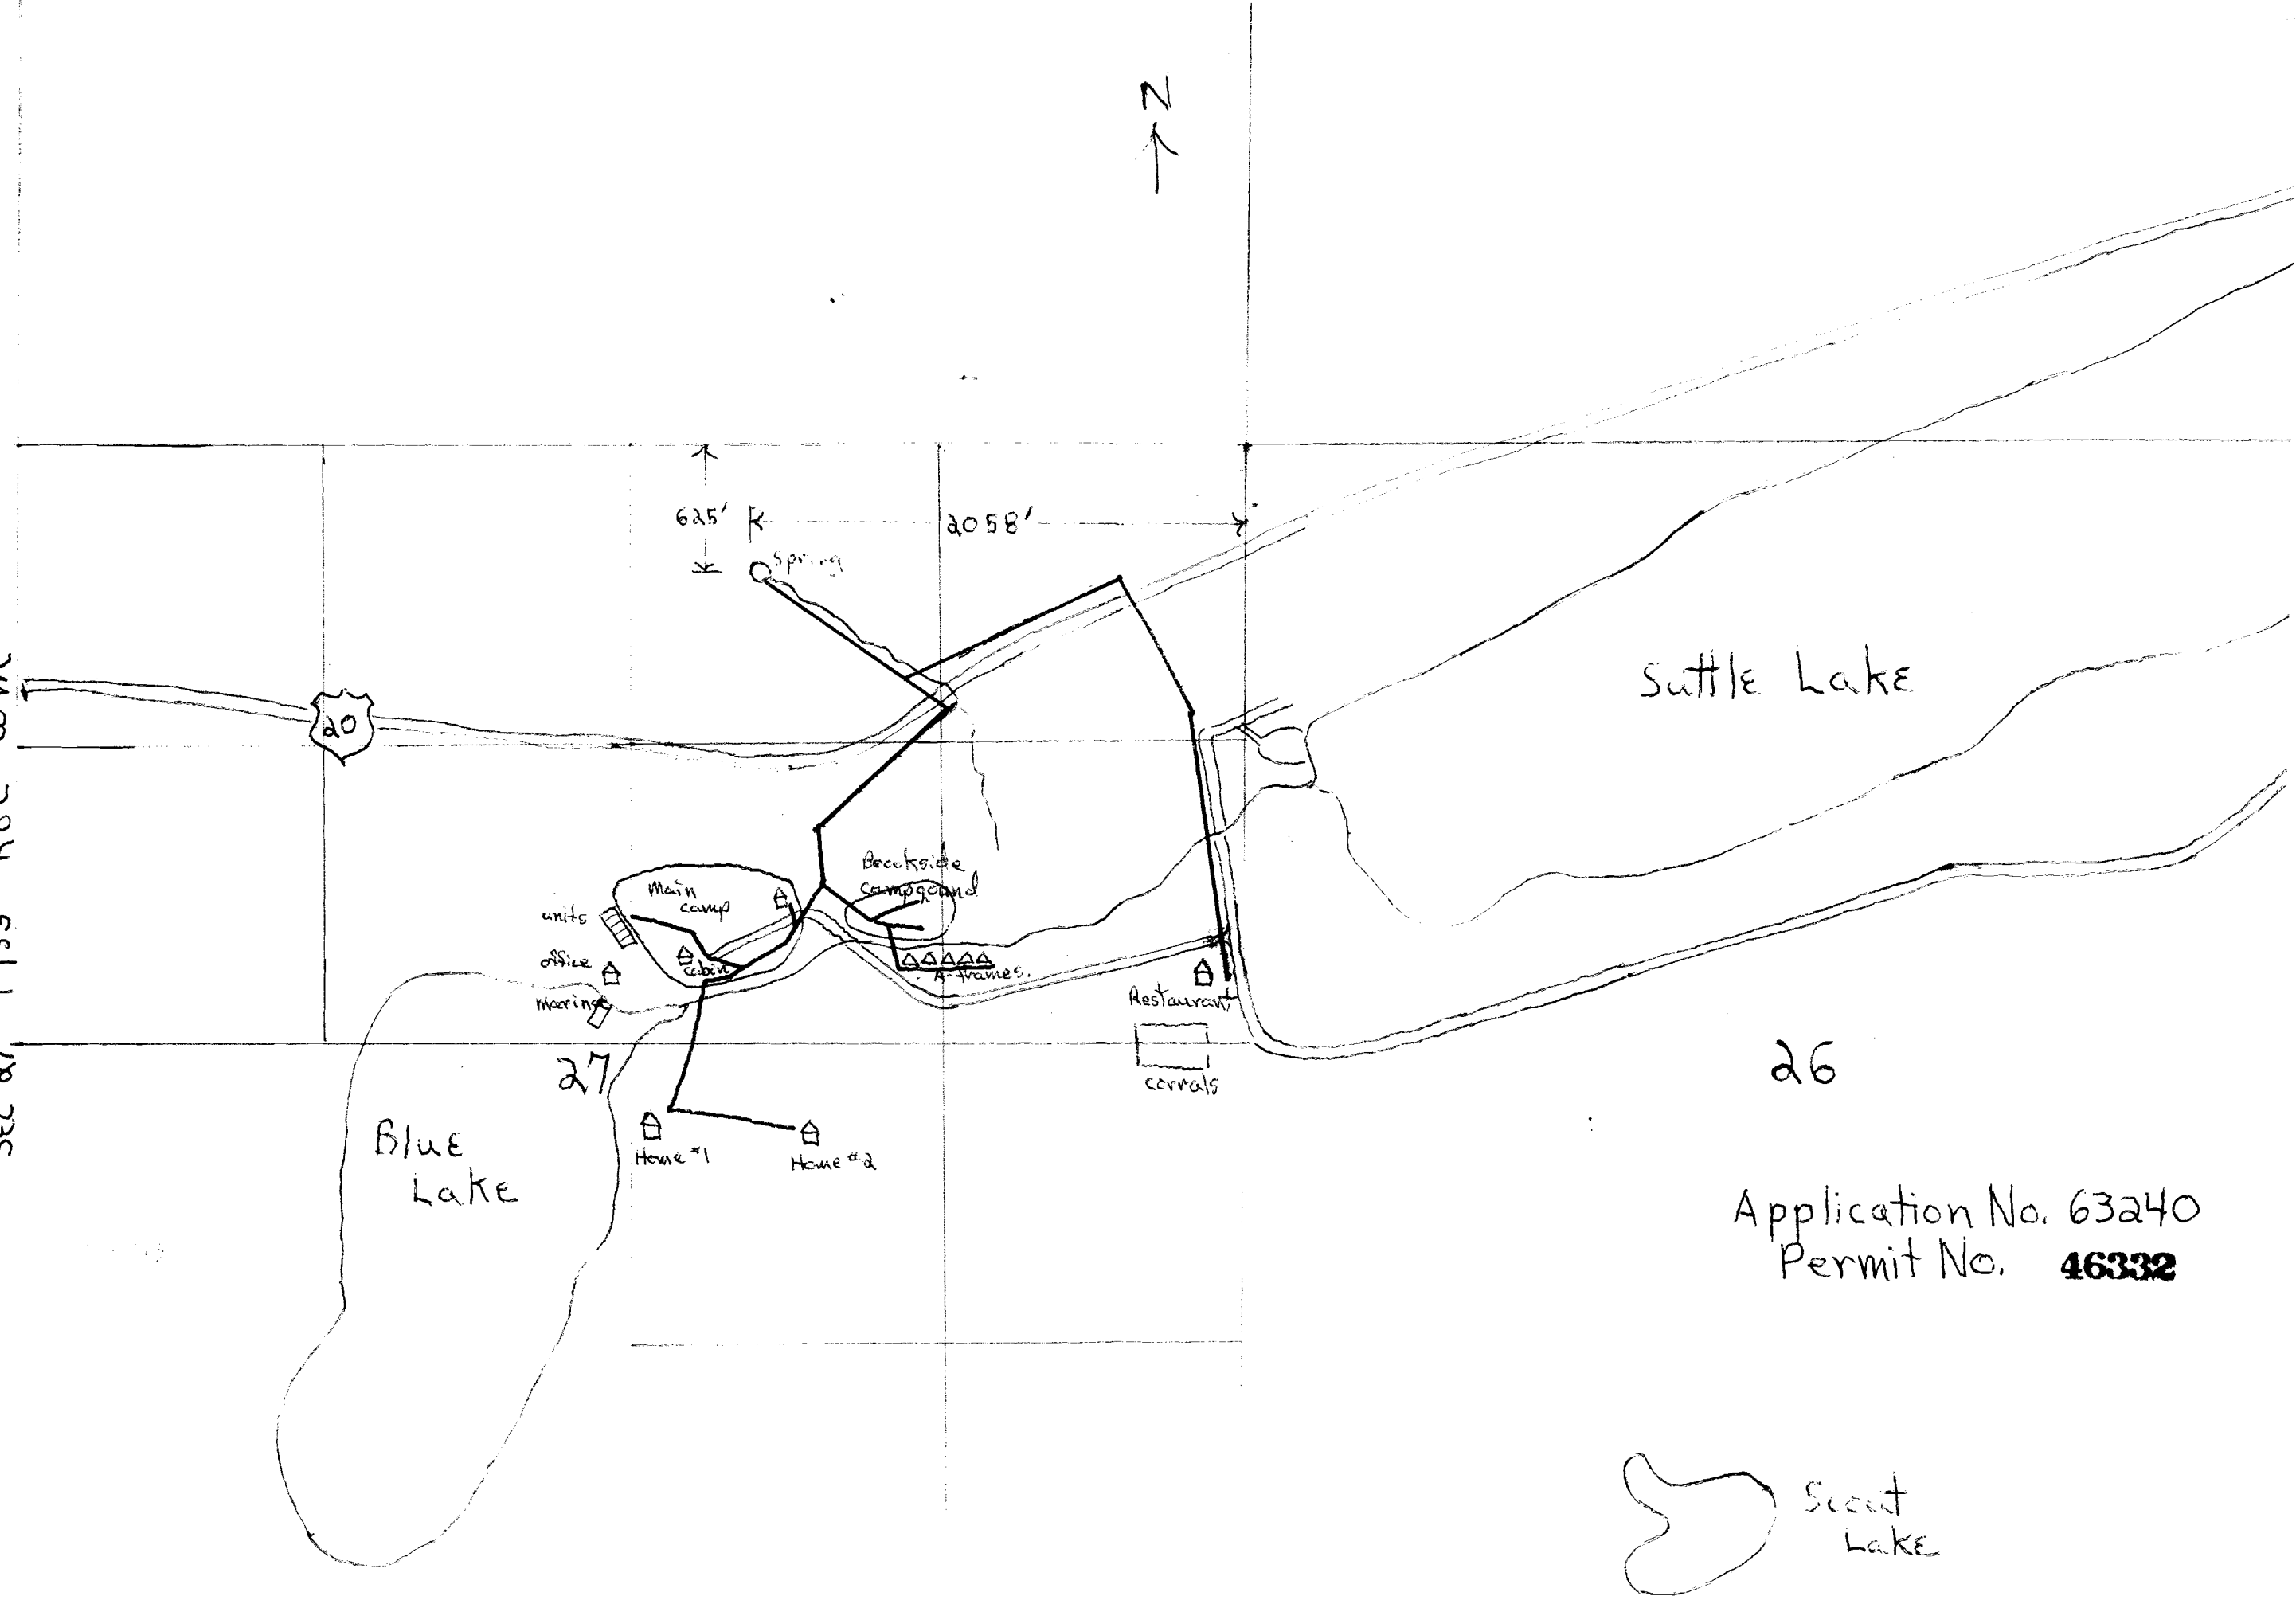

Application No. 63240
Permit No. 46332