
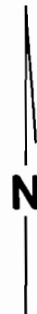


T. 28 S., R. 11 W., W.M.

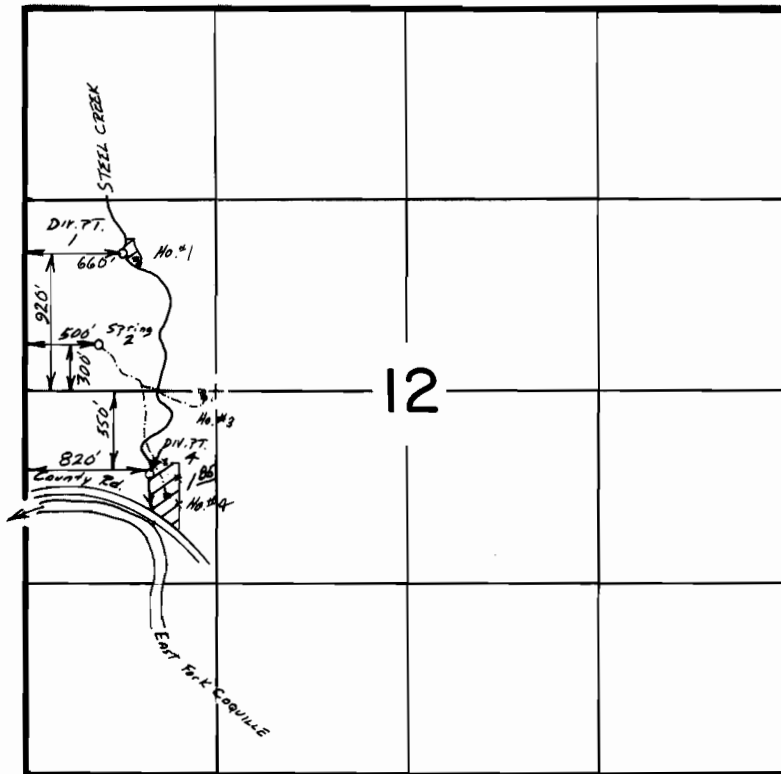

Scale 1" = 1320'

FINAL PROOF SURVEY UNDER

Application No. 63495.. Permit No. 46992.....
IN NAME OF

LILA MAE CLARNO SHELTON

Surveyed Nov... 8... 1988, by B.S. JAMES.....