


T. 7 S., R. 1 W., W. M.

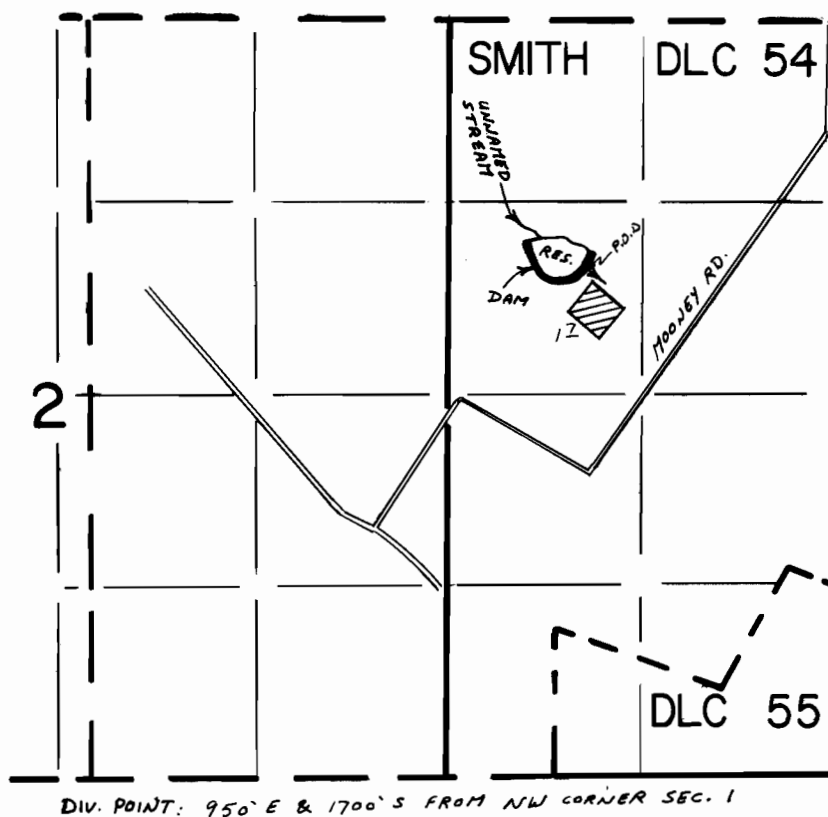

SCALE 1" = 1320'

FINAL PROOF SURVEY

UNDER

R-63549

R-8495

Application No. 63550 Permit No. 46993

IN NAME OF

ROBERT W. & ELIZABETH R. McDONALD

Surveyed JULY 5 1988, by Z. SALEH