

T-5262


T-5262

T. 8 S. R. 19 E. W.M.

RECEIVED

MAY 11 1983

WATER RESOURCES DEPT.  
SALEM, OREGON

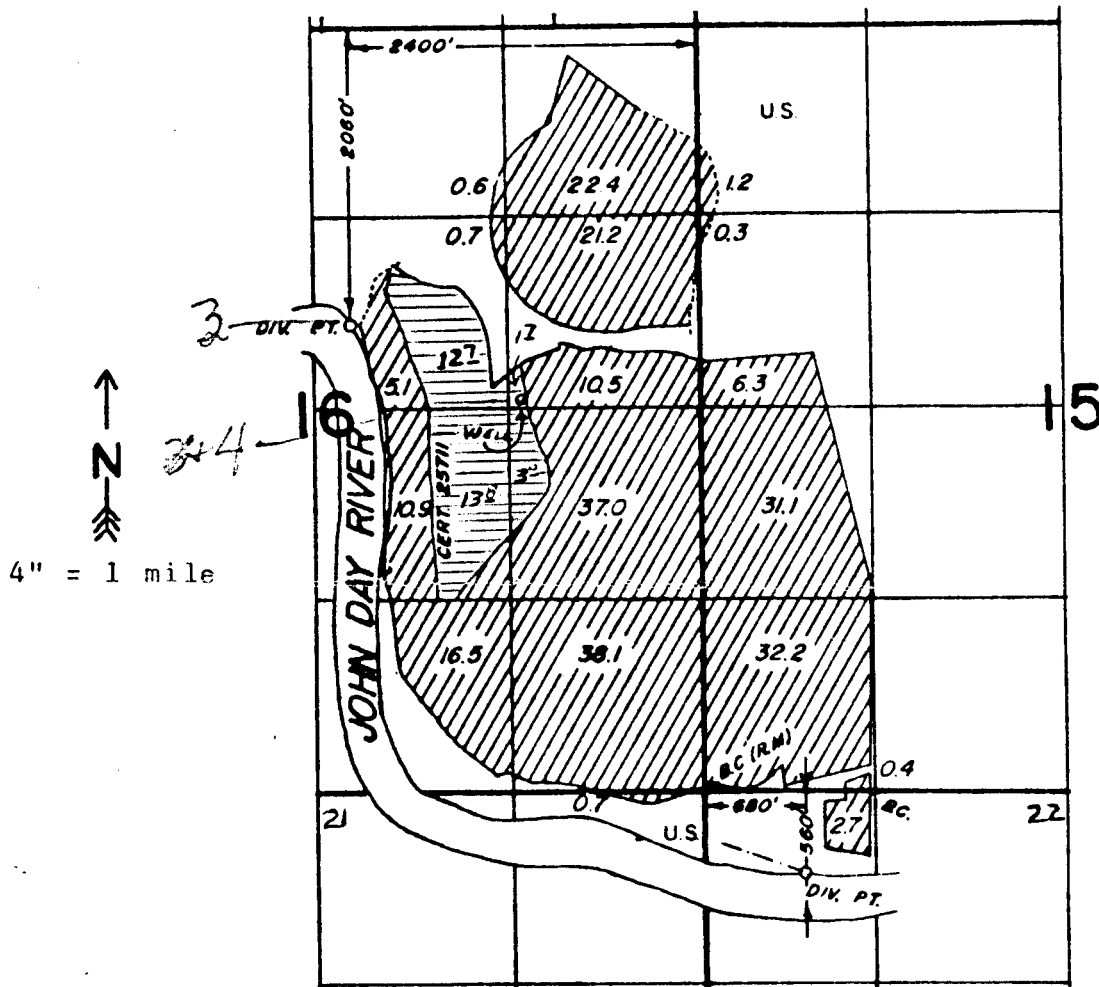

Authorized Diversion is 260'S & 1090'E from NW corner of Sec. 22 being the point above in the NW $\frac{1}{4}$ NW $\frac{1}{4}$  of Sec. 22 as found by a Final Proof Survey.

⊖ C-45124

⊗ P-41914