


T 2S. R. 2W. WM.

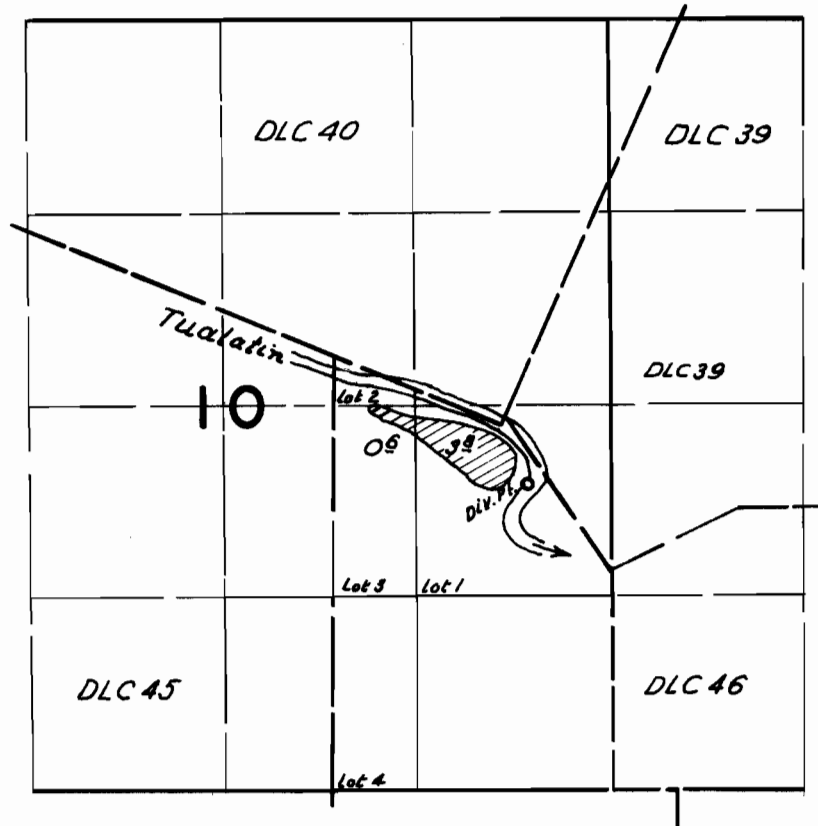

FINAL PROOF SURVEY

UNDER

Application No. 27966 Permit No. 22484

IN NAME OF

*Vola May Lund*

Surveyed Sept. 16 1959., by C.O. Bartels