


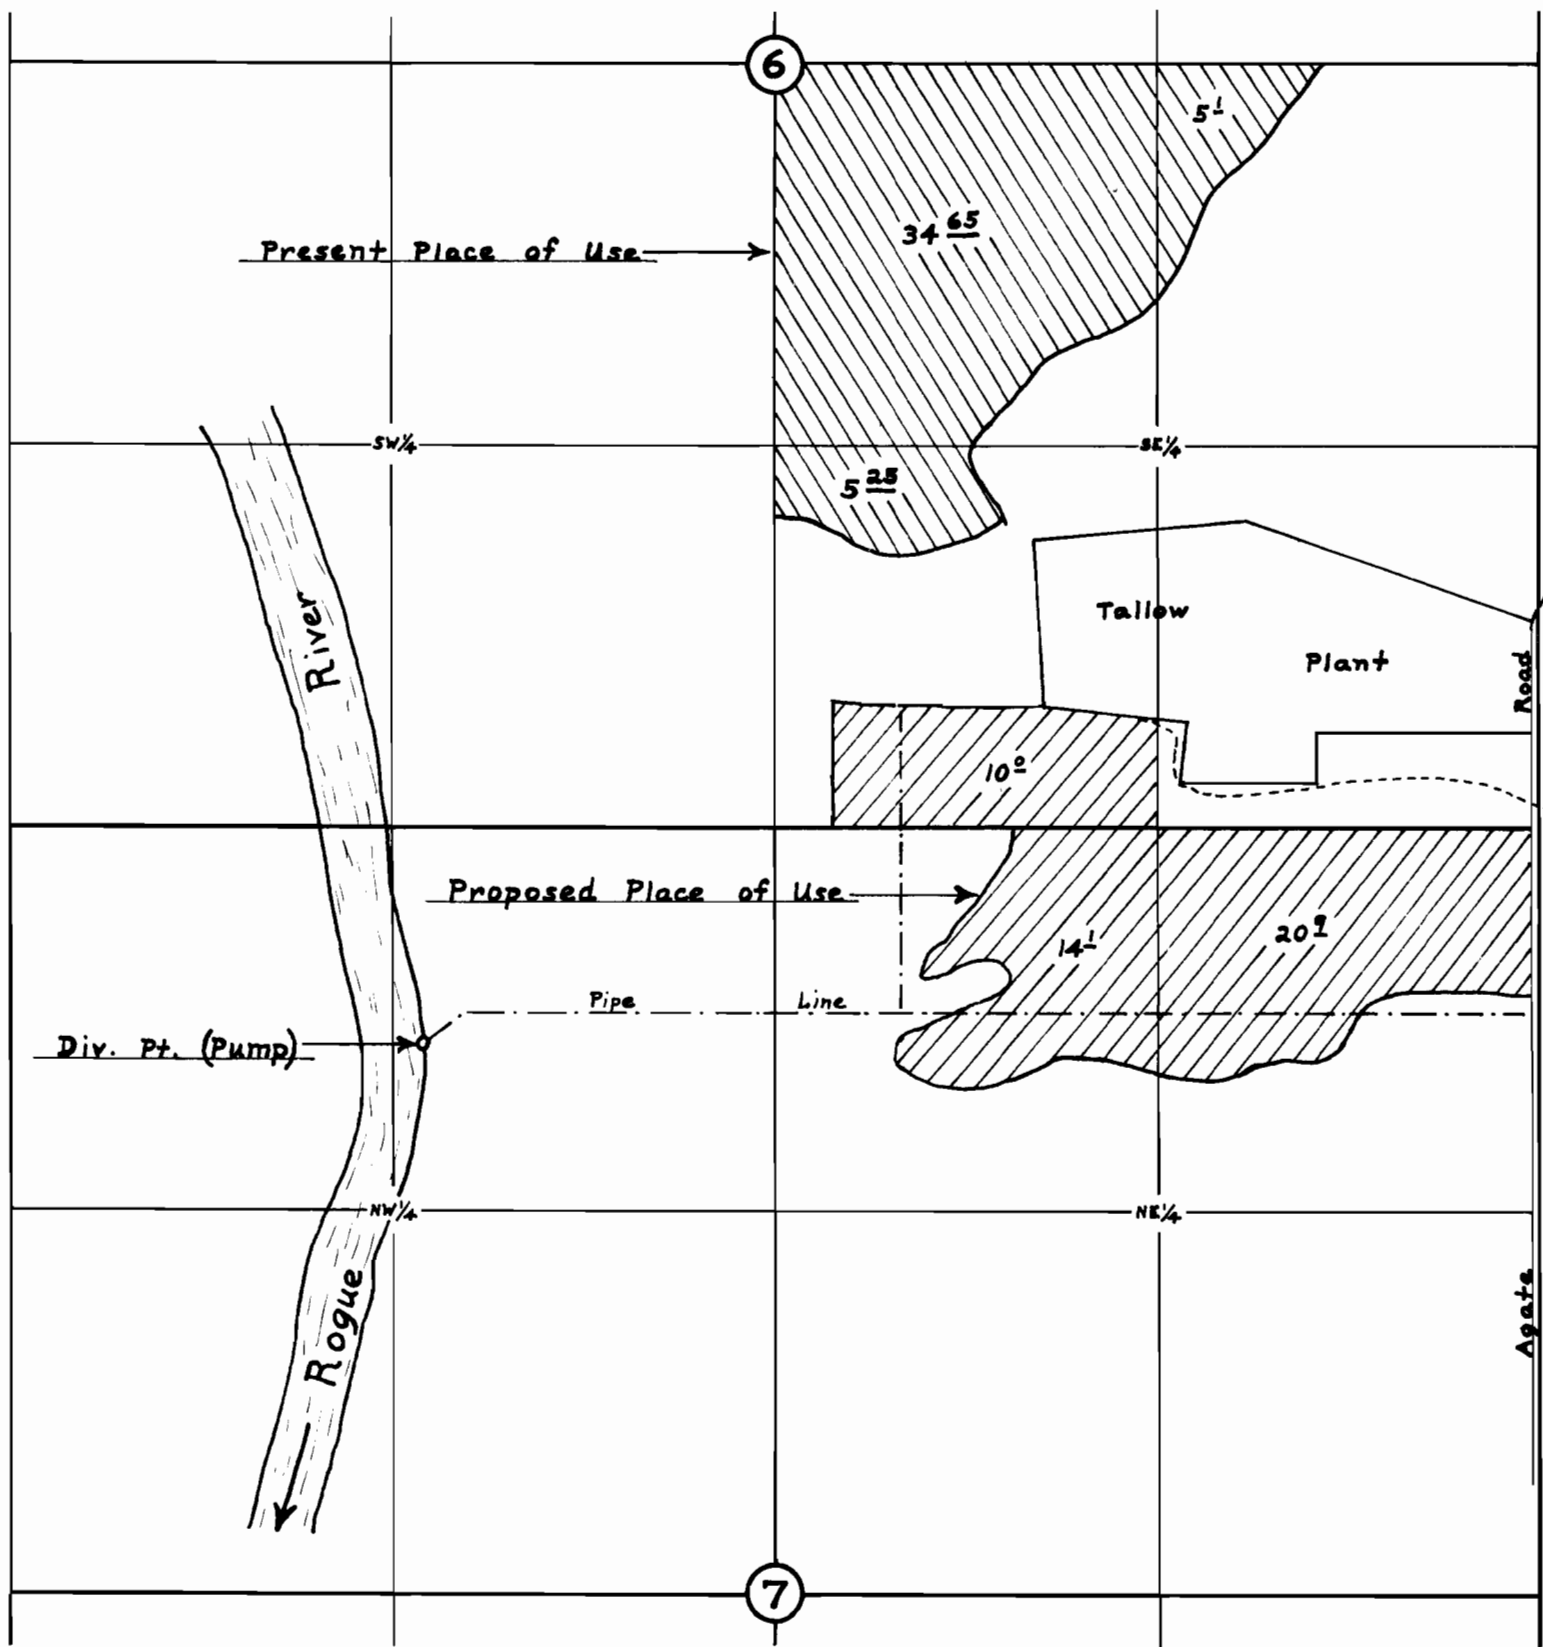

Transfer map for John N. Winton

Feb. 19, 1961 Scale: 8" = 1 mile

Map prepared by D. C. Hendrix

5-1-77 P. 25

10-7-77