


T.26S., R.6W., W.M.

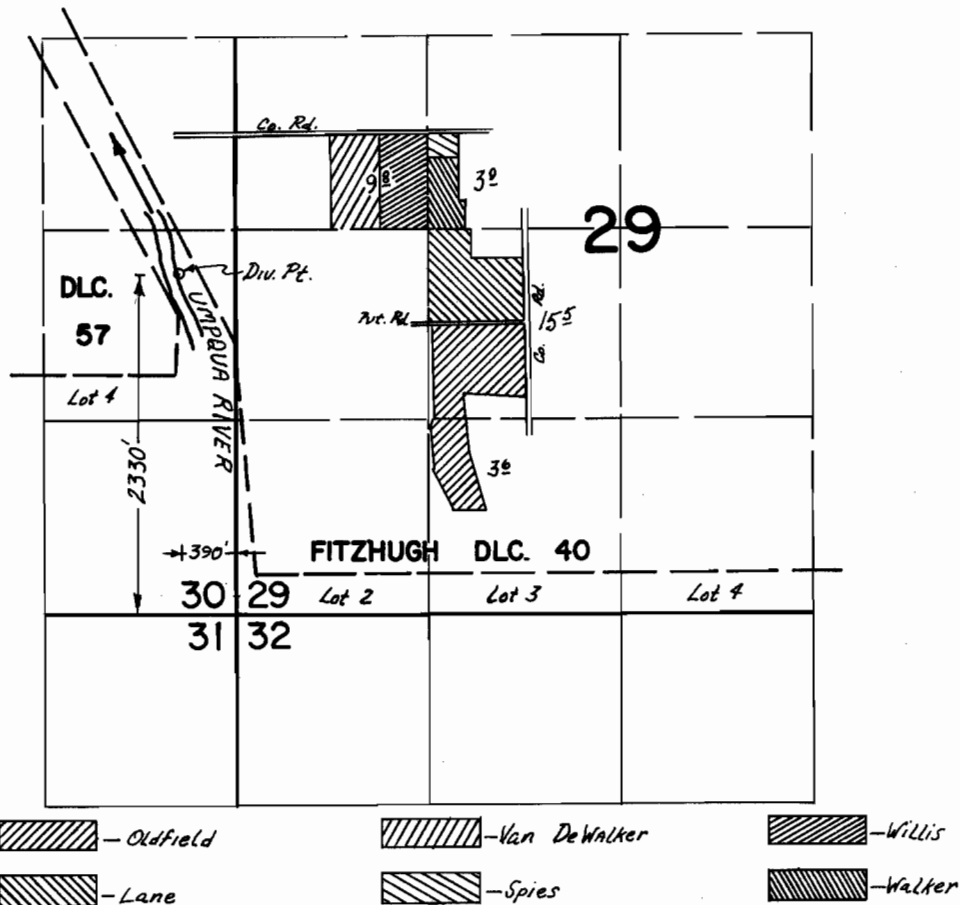

FINAL PROOF SURVEY UNDER

Application No. 42385 Permit No. 31663
 IN NAME OF
 FRANK VAN DEWALKER, GLENN WILLIS, ARTHUR SPIES
 JAMES OLDFIELD, FRANCIS LANE, LESTER WALKER

Surveyed 3 May 19 72, by D. NORBY