


T. 27 S. R. 6 W. W. M.

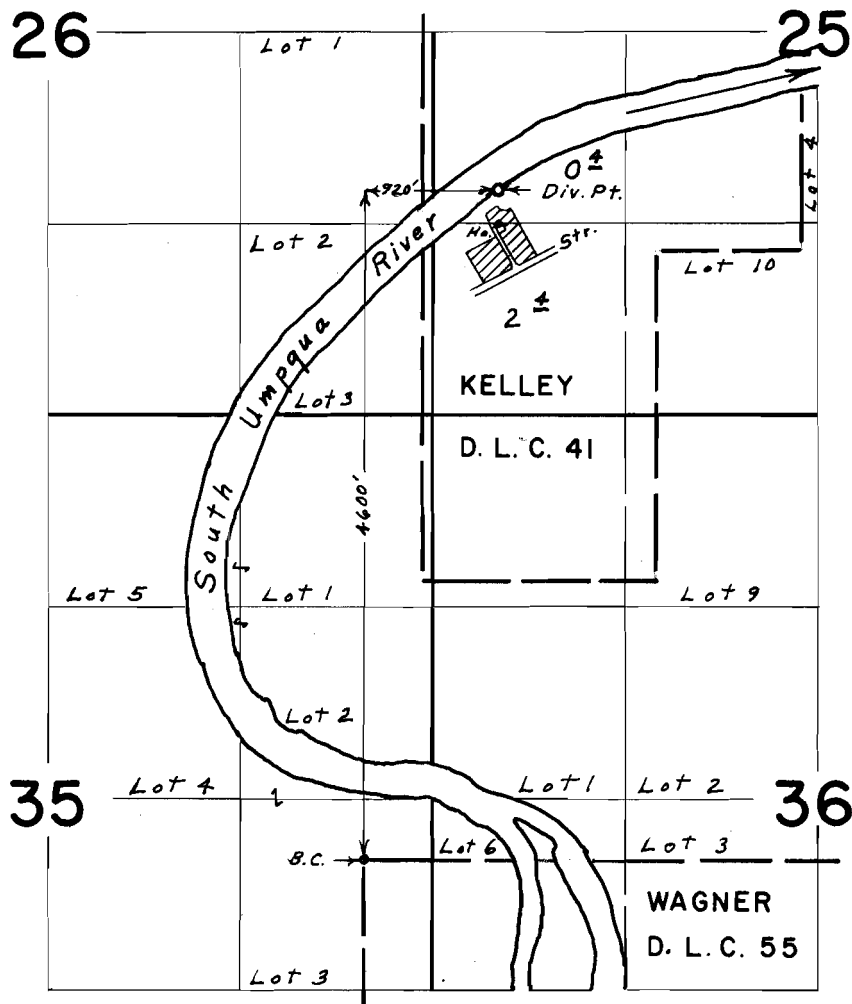

FINAL PROOF SURVEY
UNDER

Application No. 43633 Permit No. 32621
IN NAME OF

JAMES W. STEWART

Surveyed April 12, 1971, by L. E. Gould