


T10 S. R. 2 W. W. M.

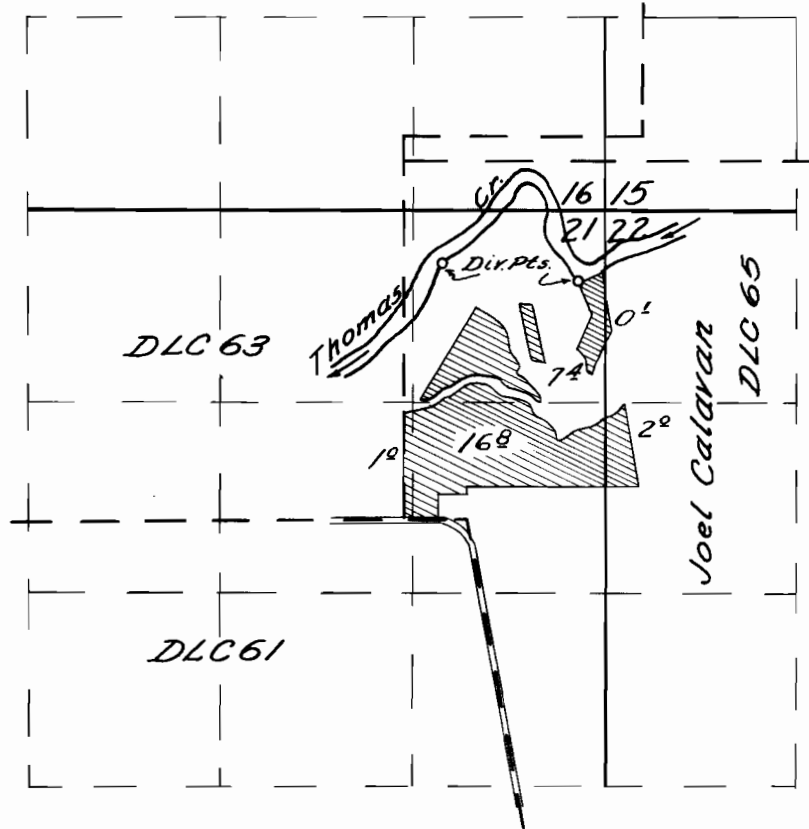

**FINAL PROOF SURVEY**  
UNDER

Application No. *2564B*. Permit No. *20113*...  
IN NAME OF

*Walter R. & Anna M. Johnson*

Surveyed *July 25, 1956*, by *R. H. Whitby*.

DFN-3D-206