


90884

(T.5541)

T.25S.,R.14E.,W.M.

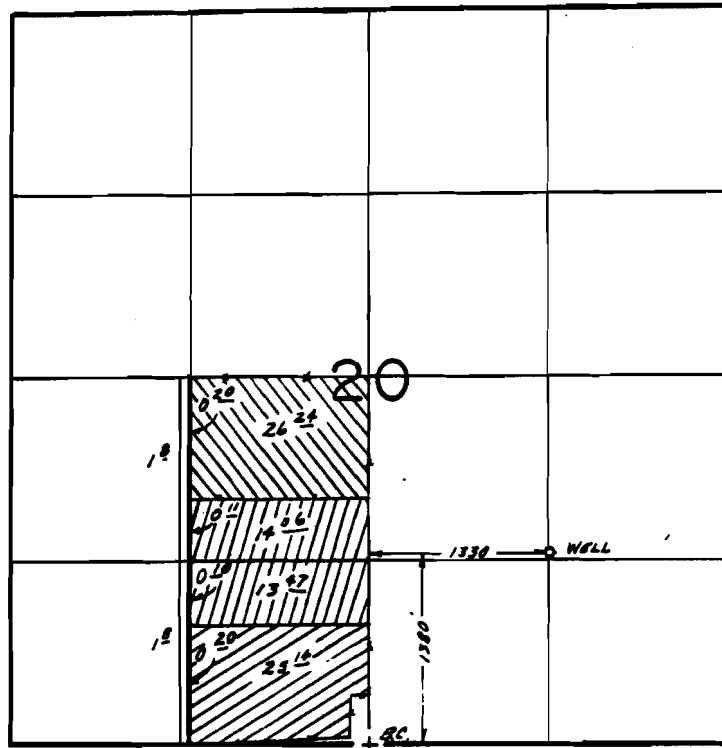

-  Tr. 5541
-  Tr. 5540
-  Tr. 5539

SCALE: 1" = 1320'

FINAL PROOF SURVEY
UNDER

Transfer No. 5539, 5540 & 5541
IN NAME OF

BANFIELD VETERINARY HOSPITAL, INC.

Surveyed Sept. 15, 1985, by B.W. BISHOP.....