


T.1N. R.4W.W.M.

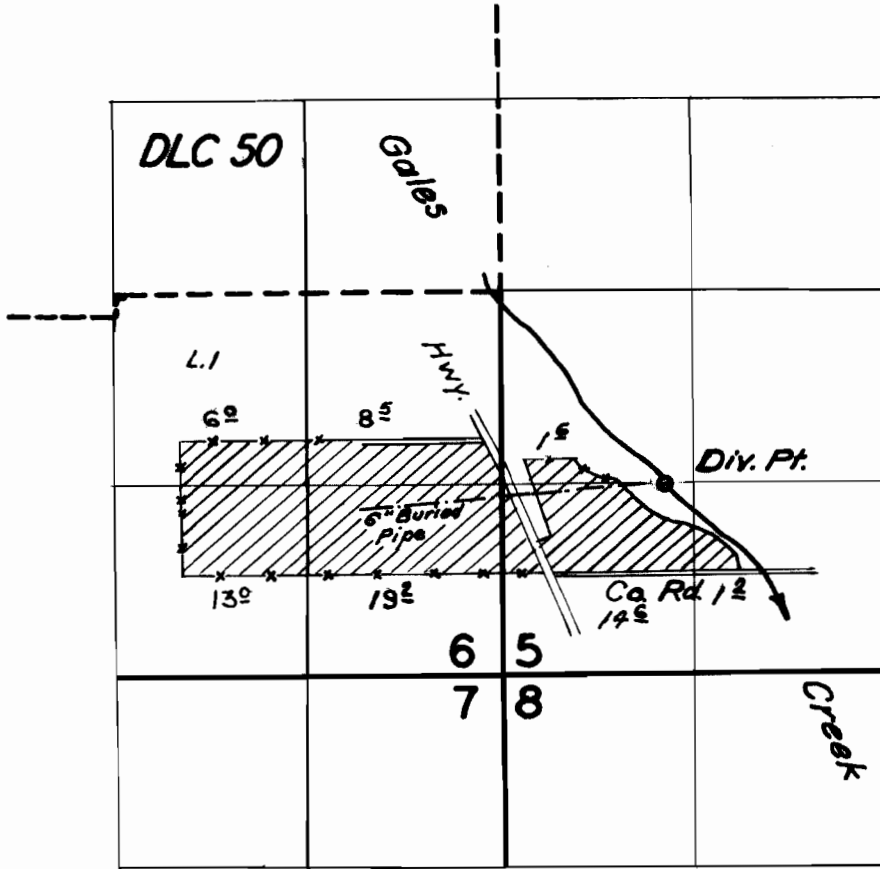

**FINAL PROOF SURVEY**  
UNDER

Application No. *3290.3* Permit No. *26010*  
IN NAME OF

*Harrison Heisler*

Surveyed *31 May* 1962, by *Carl R. Baker*.