


T.30S., R.4W., W.M.

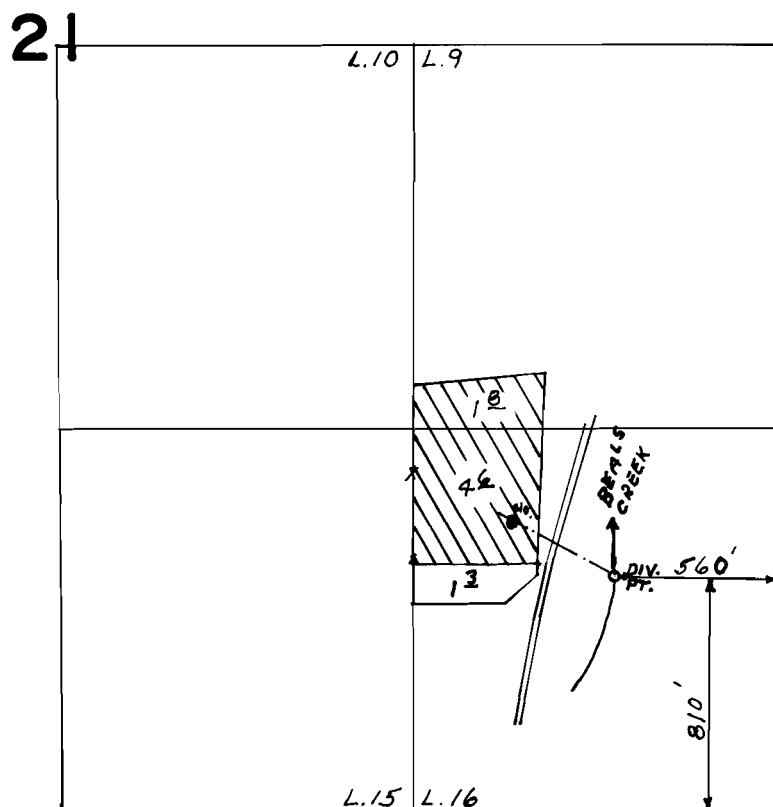

SCALE: 1" = 660'

FINAL PROOF SURVEY
UNDER

Application No. 53535... Permit No. 40321...
IN NAME OF

.....GEORGE M. HAYTER.....

Surveyed APR. 26 1977, by D.M. NORBY.....