


**T. 10 S. R. 2 W. W. M**

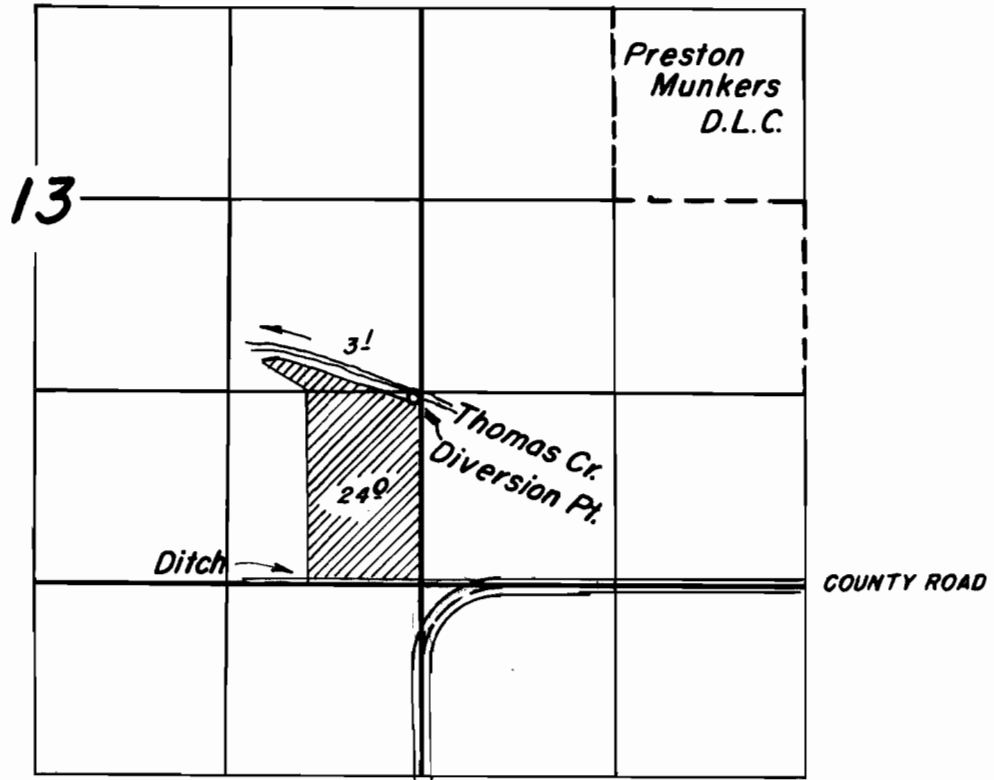

**FINAL PROOF SURVEY  
UNDER**

Application No. 32827 Permit No. 25908  
IN NAME OF

Jerry Faltus

Surveyed Dec. 10, 1962, by Floyd L. Sigmond