


T-4748

T. 32 S. R. 4 W. W.M.

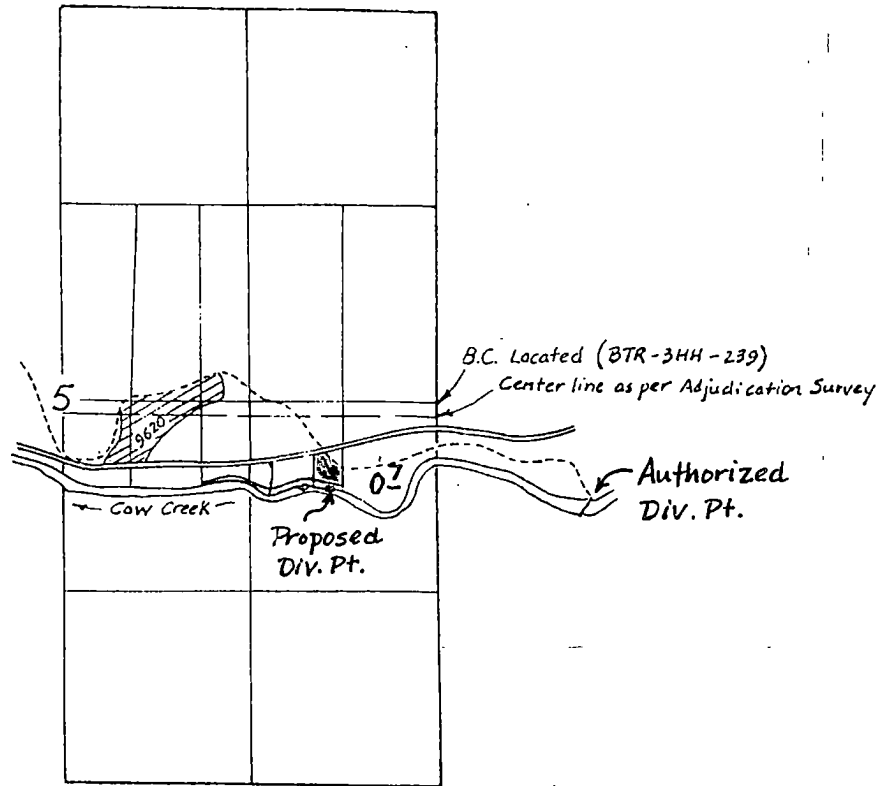

Scale: 4" = 1 mile  
Cert. 9613

Proposed Div. Pt. : 600' S. and 740' W. }  
Authorized Div. Pt. : 650' S. and 1050' E. } from E  $\frac{1}{4}$  Cor. Sec. 5