


48630
63862

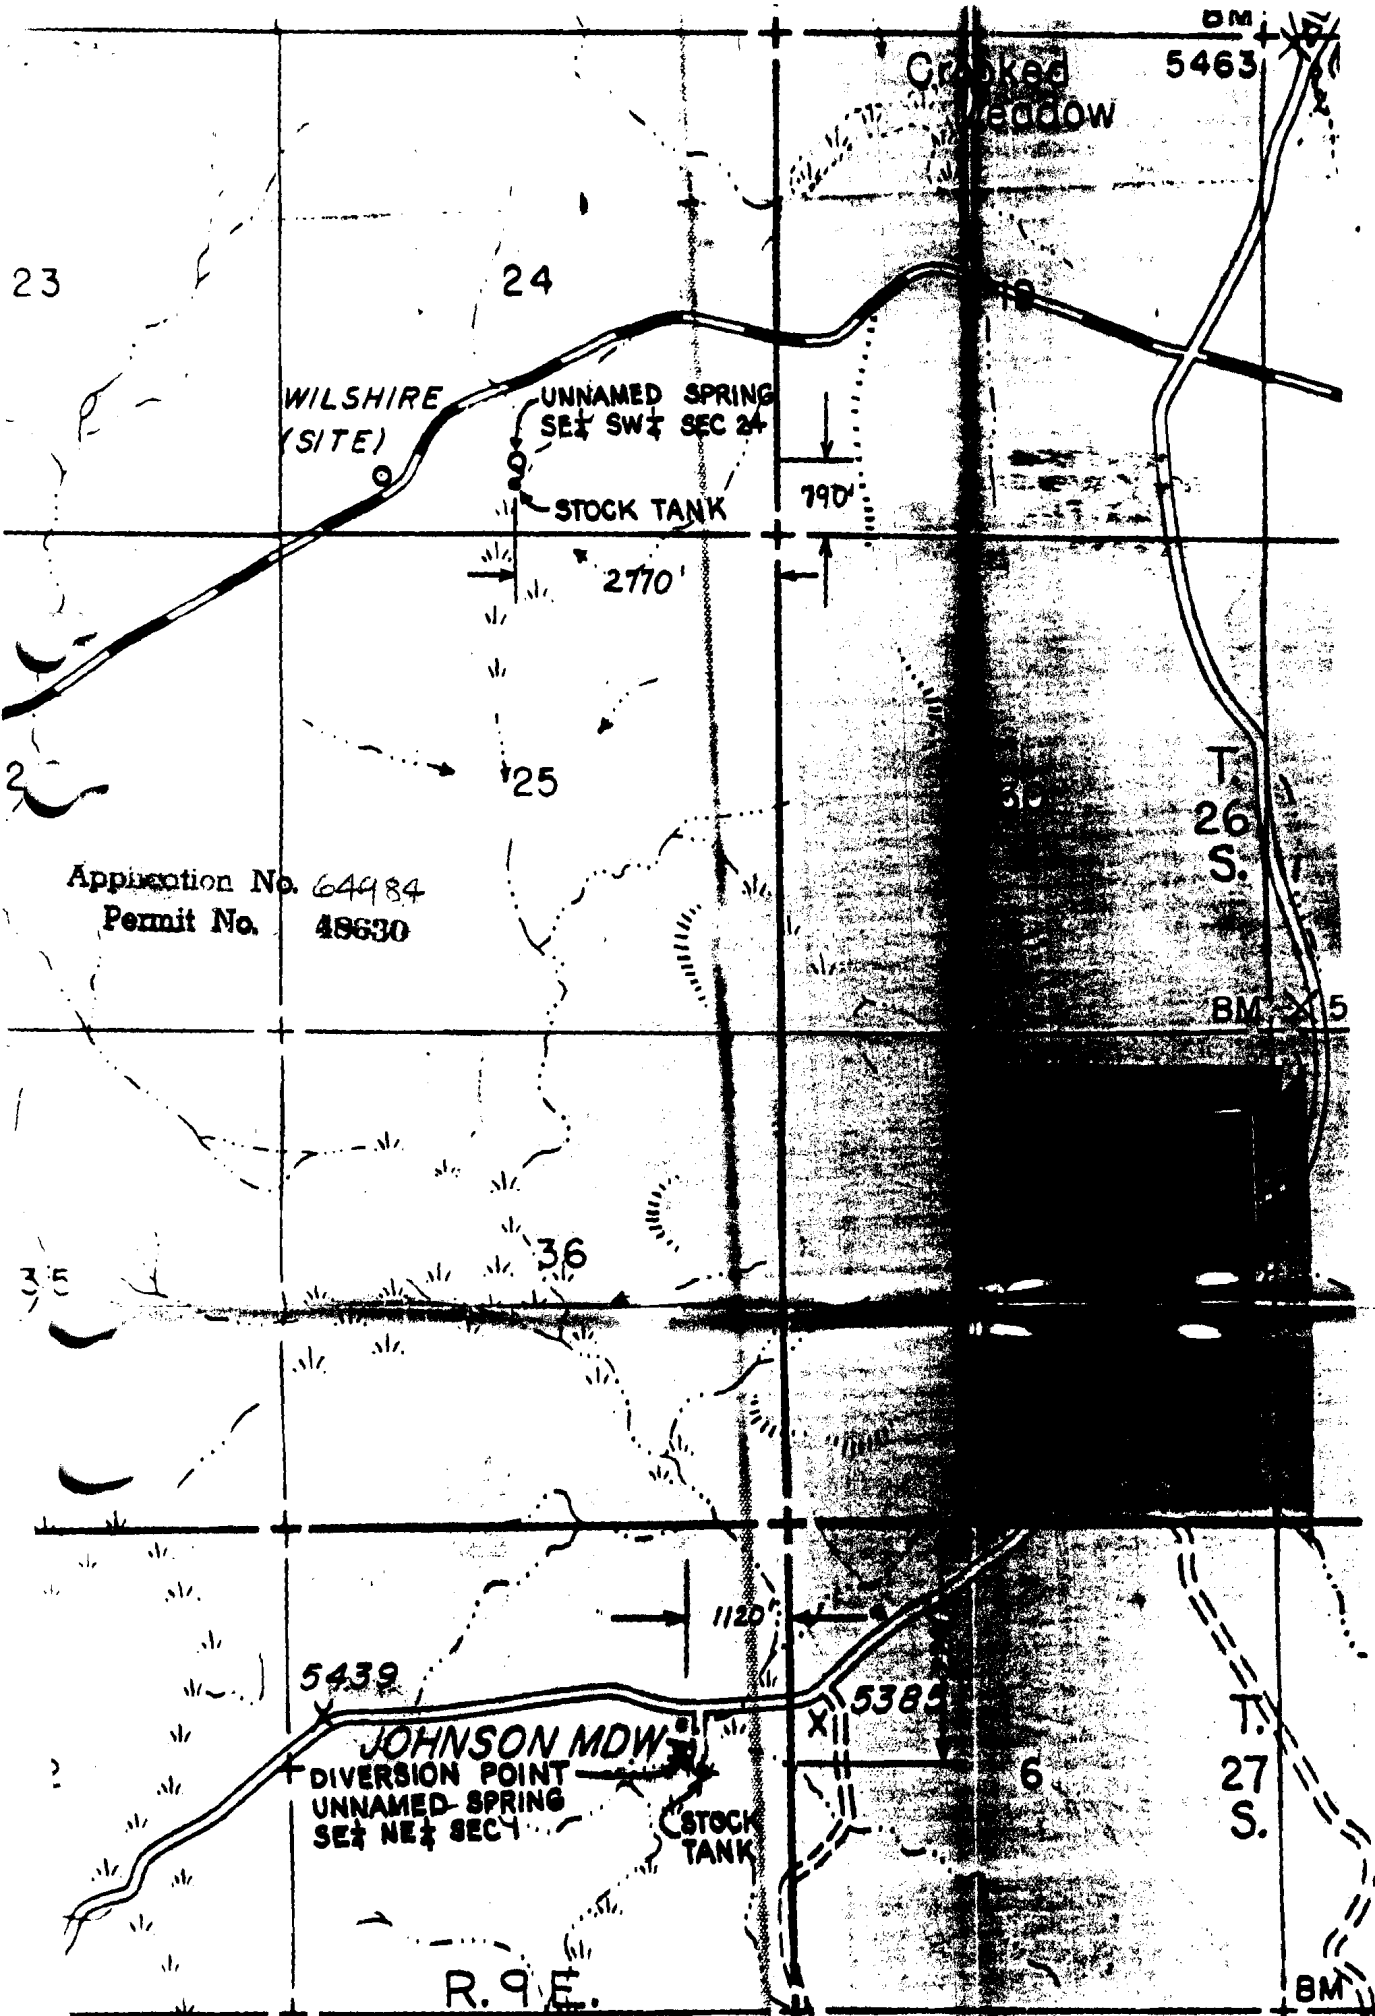

Application No. 64484
Permit No. 48630