


TOWNSHIP 6S, RANGE 28E, SECTION 26, W.M.

26

25

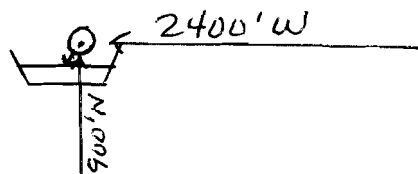

35

36

RECEIVED

FEB 28 1983

**WATER RESOURCES DEPT.
SALEM, OREGON**

NAME TEEPEE SPRING COUNTY MORROW

Application No. 63091
Permit No. 47397