


TOWNSHIP 8 S, RANGE 26 E, SECTION 24, W.M.

14

13

24

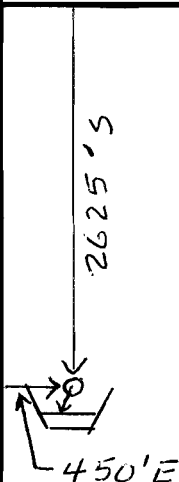

24

RECEIVED

FEB 28 1983

WATER RESOURCES DEPT.
SALEM, OREGON

NAME BOLOGNA SPRING COUNTY GRANT

Application No. 63093
Permit No. 47399