


TOWNSHIP 8S, RANGE 26E, SECTION 21, W.M.

20

21

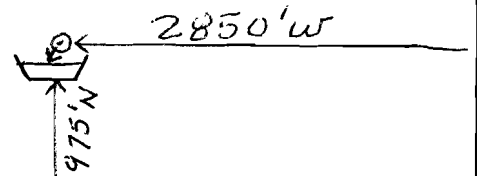

29

28

RECEIVED
FEB 28 1983
WATER RESOURCES DEPT.
SALEM, OREGON

NAME BOLOGNA RIDGE SPRING COUNTY GRANT

Application No. 63096
Permit No. 47402