


Switchback Spring

N ↑

Application No. 66310
Permit No. 48560

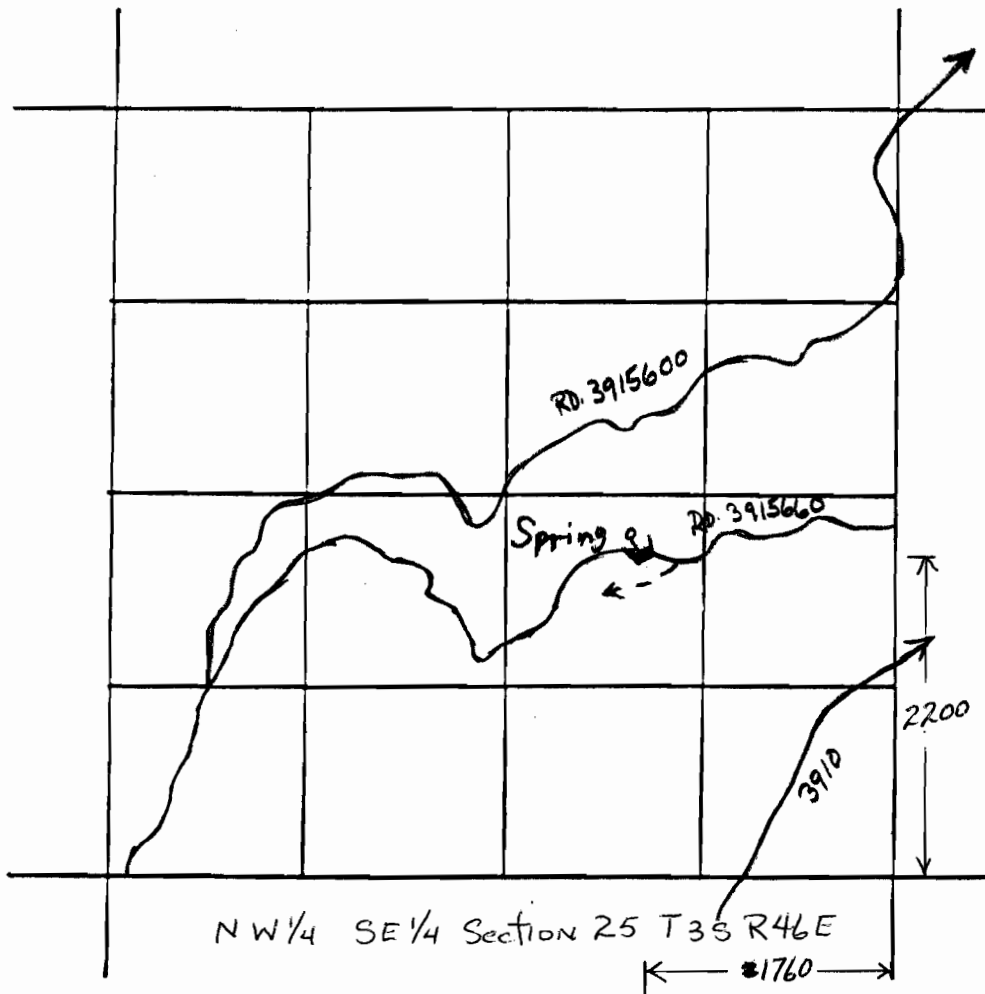

4 inches = 1 mile

RECEIVED
SEP 29 1983
LAND & MINES DEPT.
SALEM, OREGON