

N




RECEIVED

SEP 19 1983

VALLEY RIDGES DEPT.
SALEM, OREGON

Application No 66314
Permit No. 48564

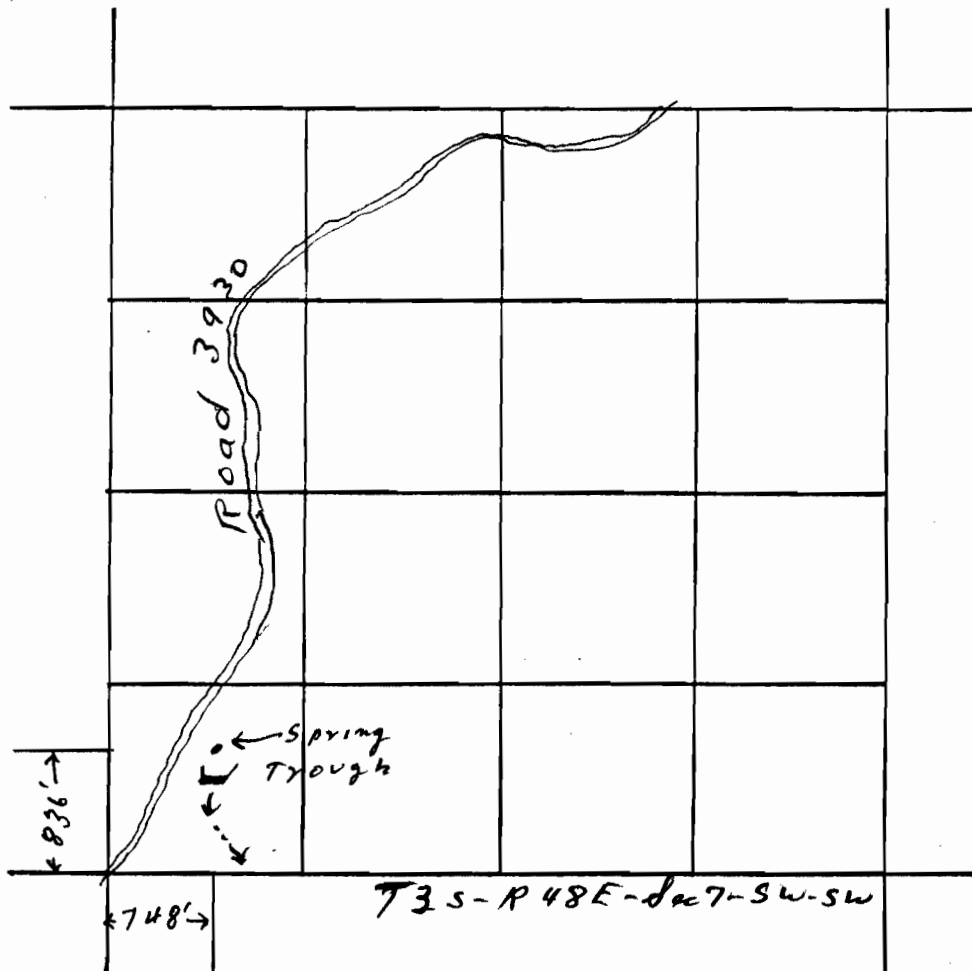

4 inches = 1 mile