


N

SEP 19 1933
WILSON & CO. LANDS DEPT.
SALEM, OREGON

Application No. 66319
Permit No. 48569

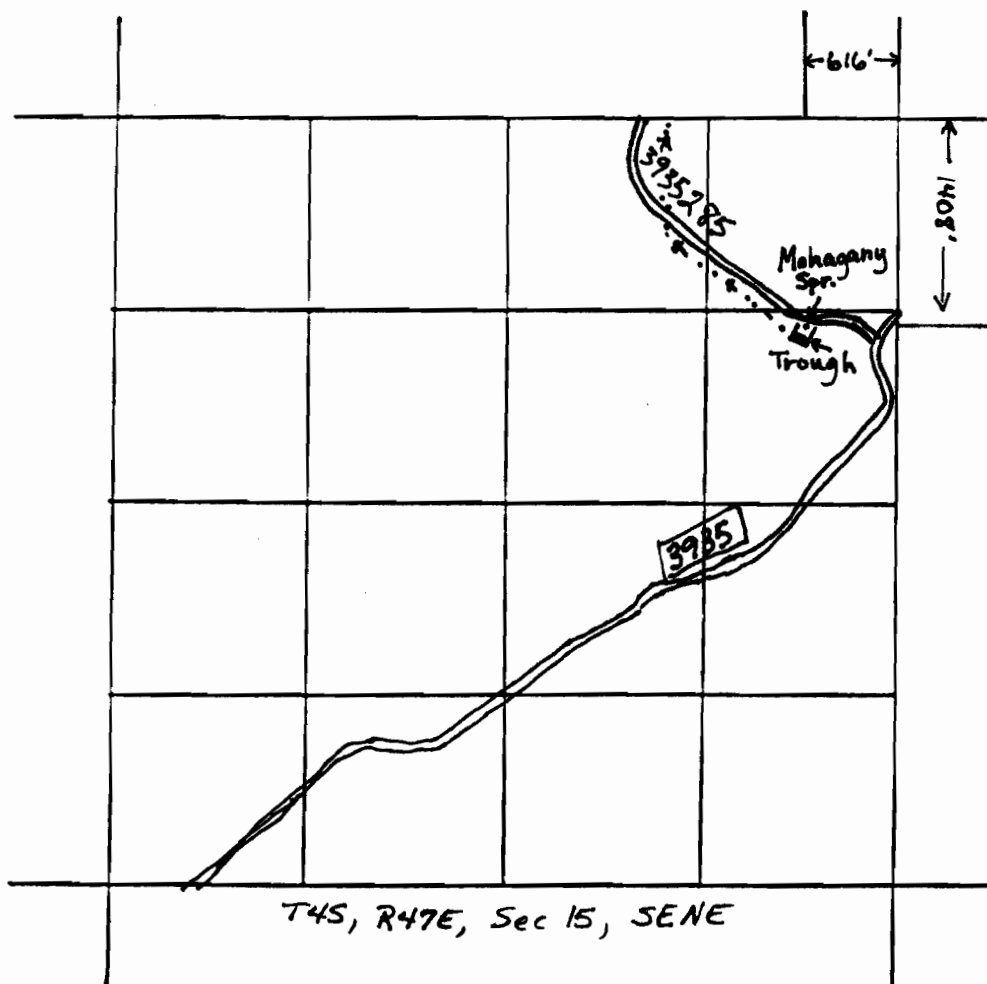

4 inches = 1 mile