

N



SEP 19 1933


WILSON COUNTY DEPT.

SALMON, OREGON

Application No. 66320

Permit No.

48570

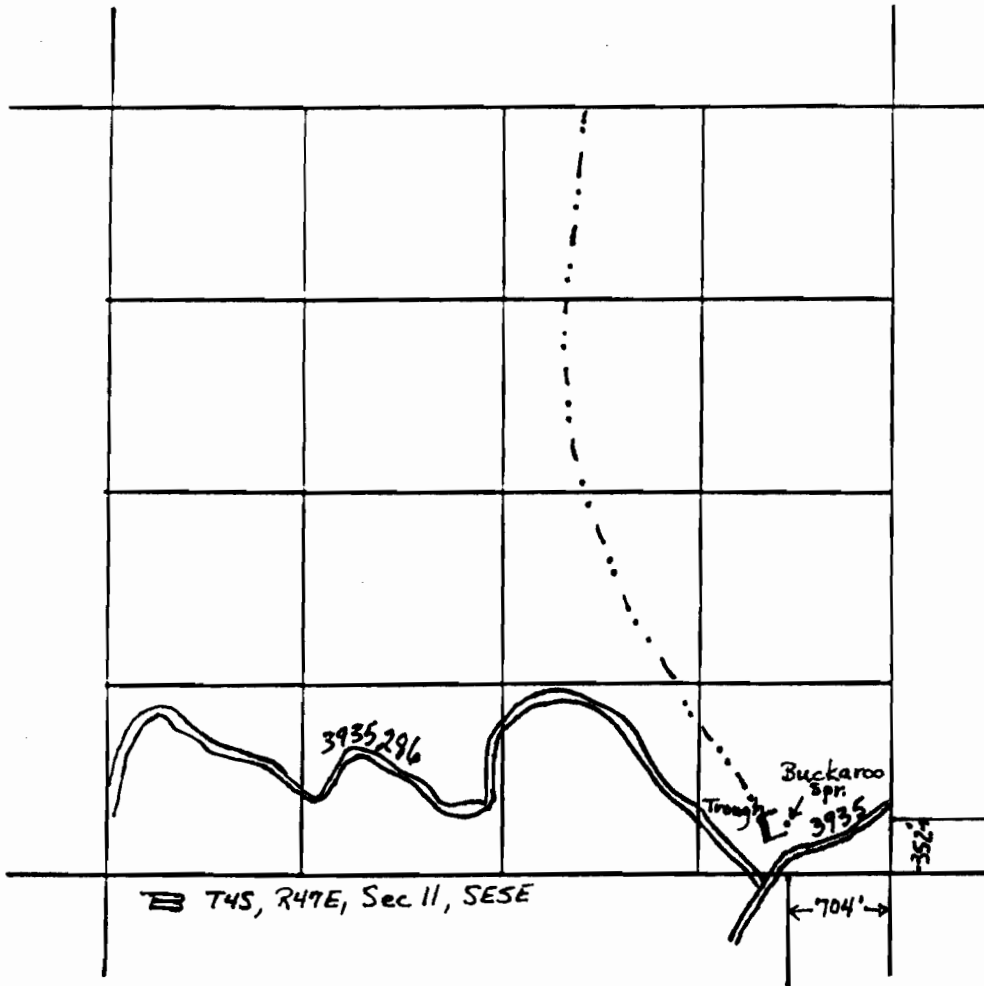

4 inches = 1 mile