


RECEIVED
SEP 9 1933
WILSON & CO. DEPT.
SALEM, OREGON



Application No. 66321
Permit No. 48571

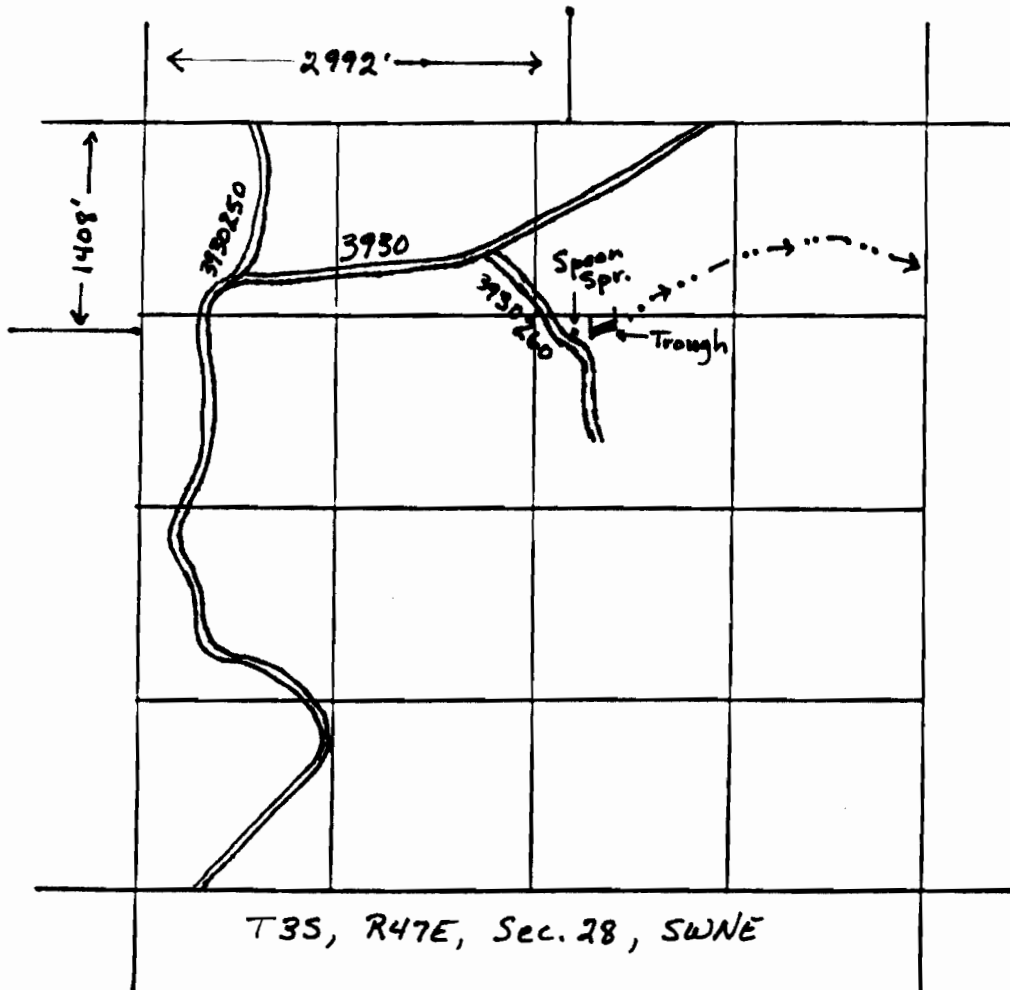

4 inches = 1 mile