




Application No. 66323

Permit No. 48573

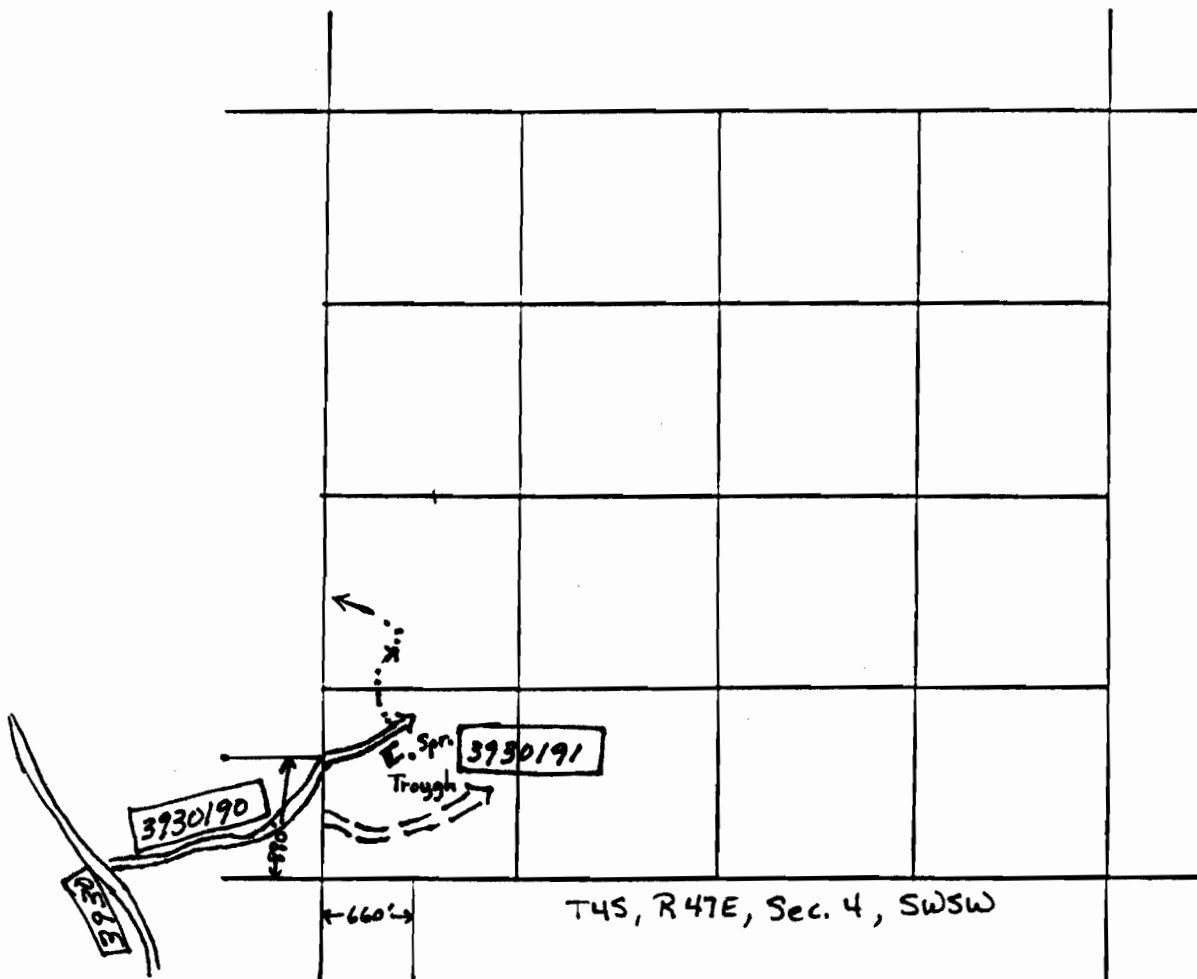

4 inches = 1 mile

RECEIVED
SEP 9 1933
V. L. K. R. B. DEPT.
SALEM, OREGON