

N




RECEIVED

SEP 9 1933

LAND & MINES DEPT.
SALEM, OREGON

Application No. 66324
48574

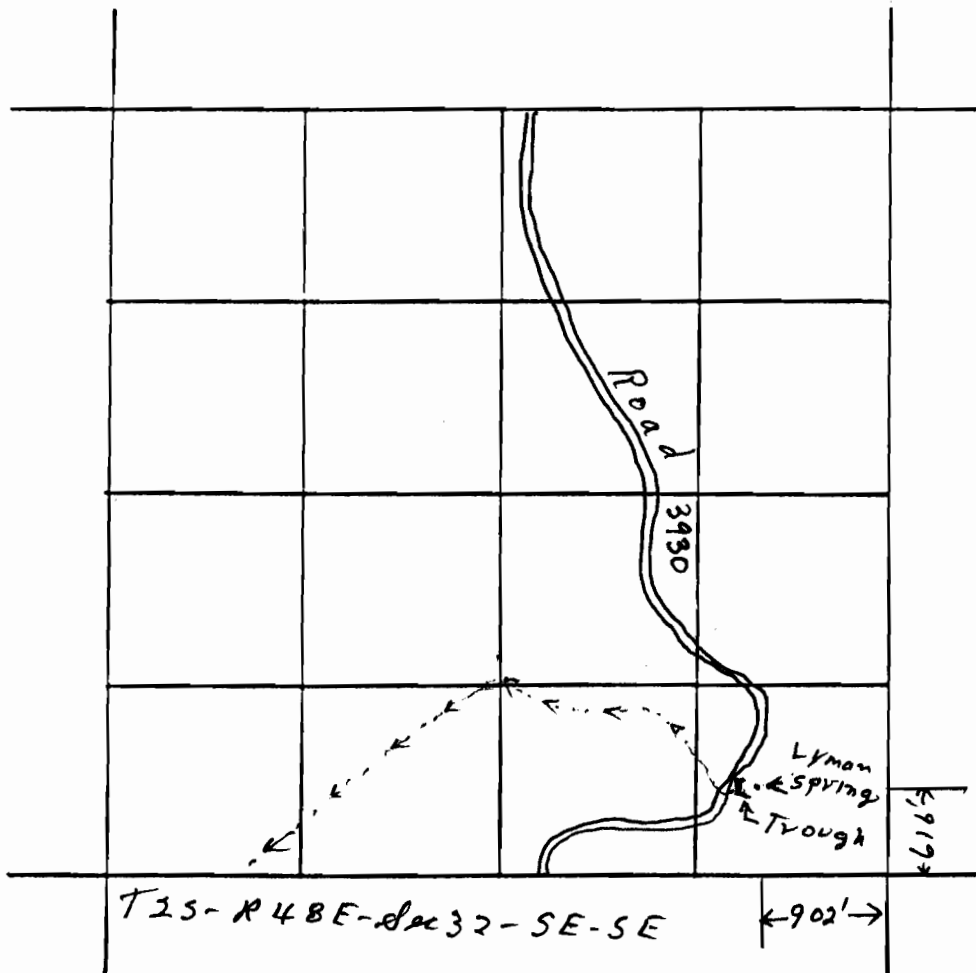

4 inches = 1 mile