


RECEIVED

SEP 11 1981

WATER RESOURCES DEPT  
SALEM, OREGON

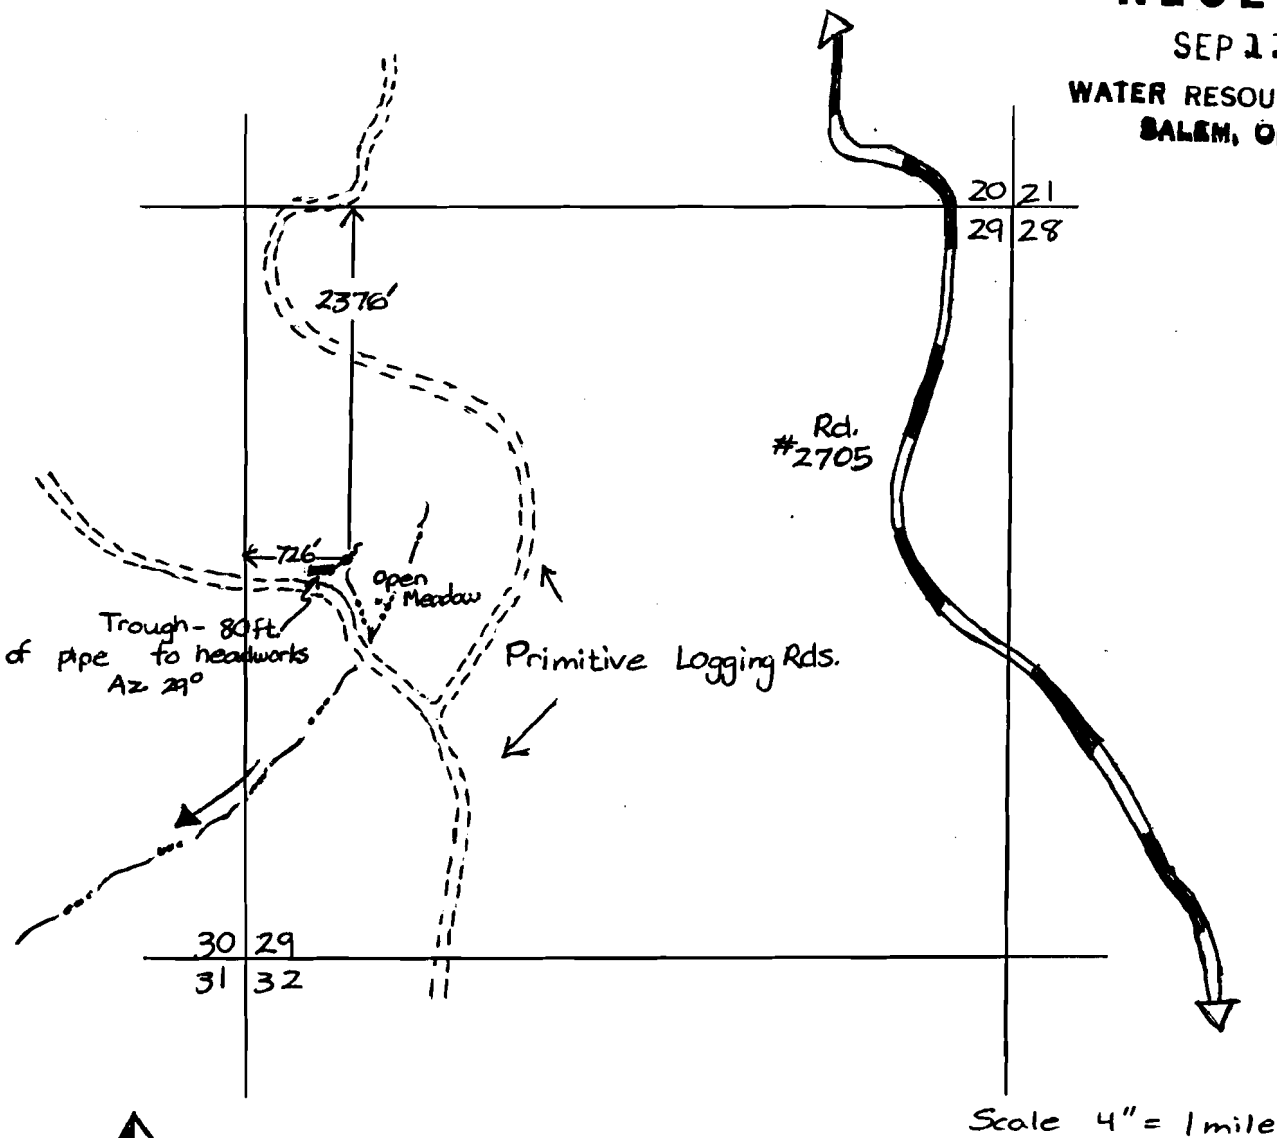

Ray Spring

SW 1/4, NW 1/4, Sec. 29, T 12S, R 17E, W.M.

Application No. 62710  
Permit No. 48644

cert. 63864

RECEIVED

DATE 2-28-90

WATER MASTER DISTRICT #11

BY *[Signature]*

48644