


RECEIVED

SEP 11 1981

WATER RESOURCES DEPT
SALEM, OREGON

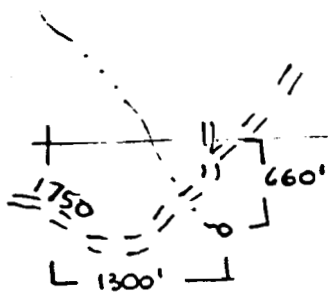

Sanford Spring

T. 17S. R. 18E. Sec. 28

28



4" = 1 MILE

T. Bedortha


Aug. 1981

spring development

Application No. 62714

Permit No. 48647

cert. 63865

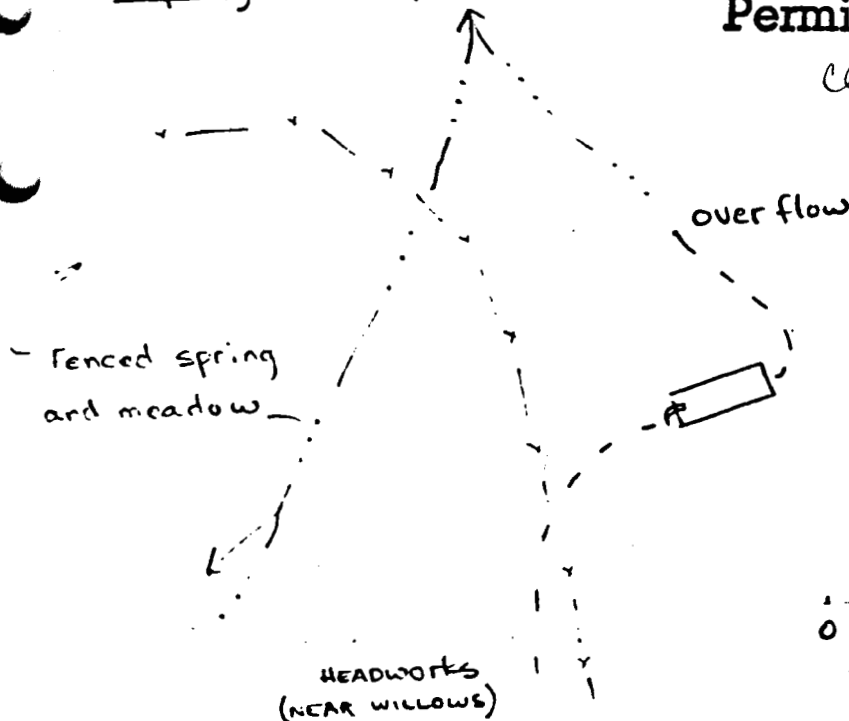

RECEIVED

DATE 2-28-90

WATER MASTER DISTRICT #11

BY JMS



0 10 20 30
FEET

C-63865

48647