


RECEIVED

SEP 11 1981

WATER RESOURCES DEPT
SALEM, OREGON

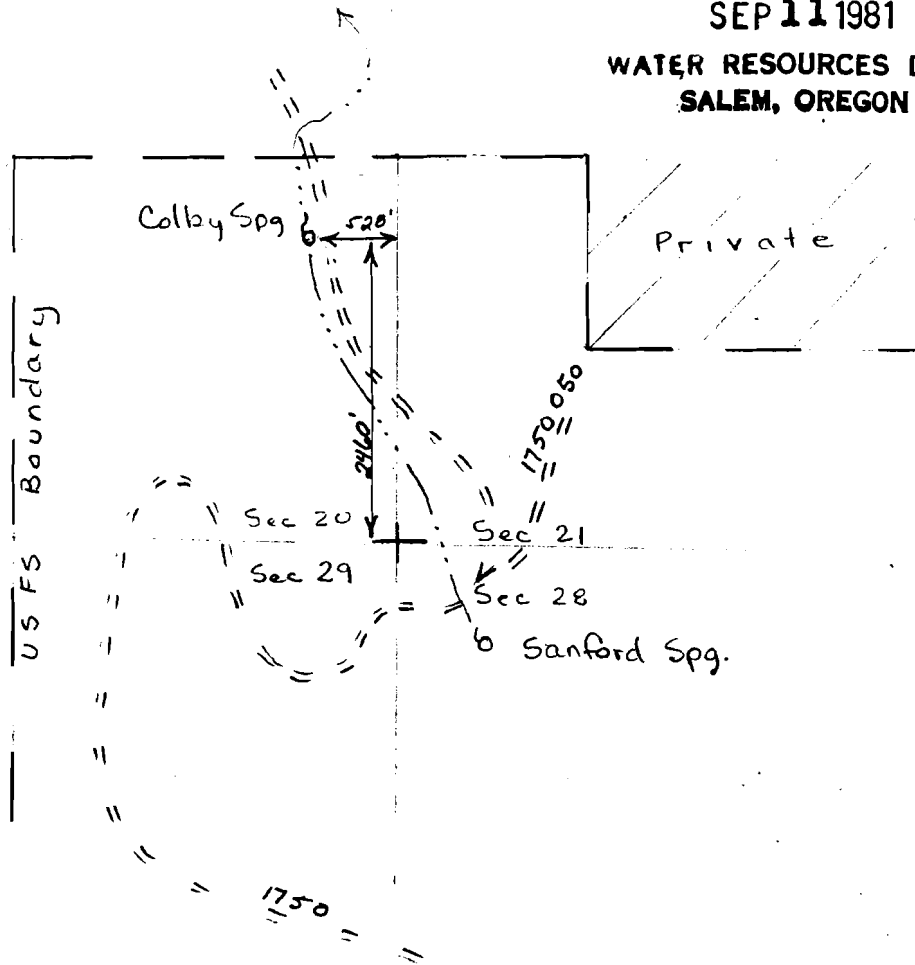

Colby Spring

T. 17S. R. 18E. Sec 20


4" = 1 MILE

T. Bedortha
Aug. 1981

Application No. 62715
Permit No. 48648

Spring development

Cert. 63866

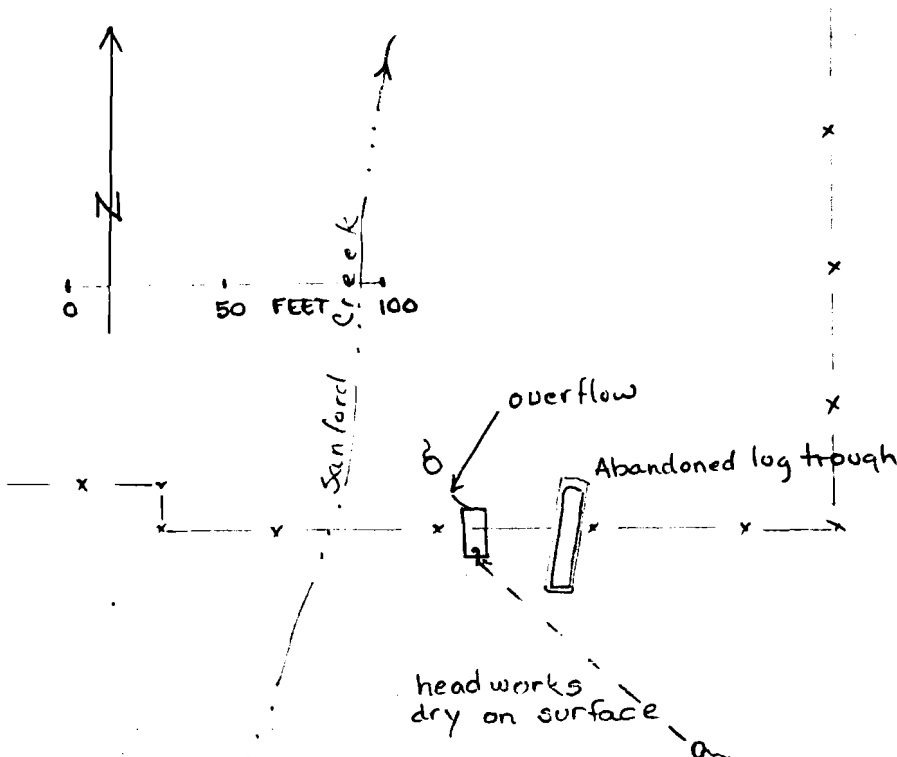

RECEIVED

DATE 2-28-90

WATER MASTER DISTRICT #11

BY *SM*

48648