


RECEIVED

SEP 11 1981

WATER RESOURCES DEPT
SALEM, OREGON

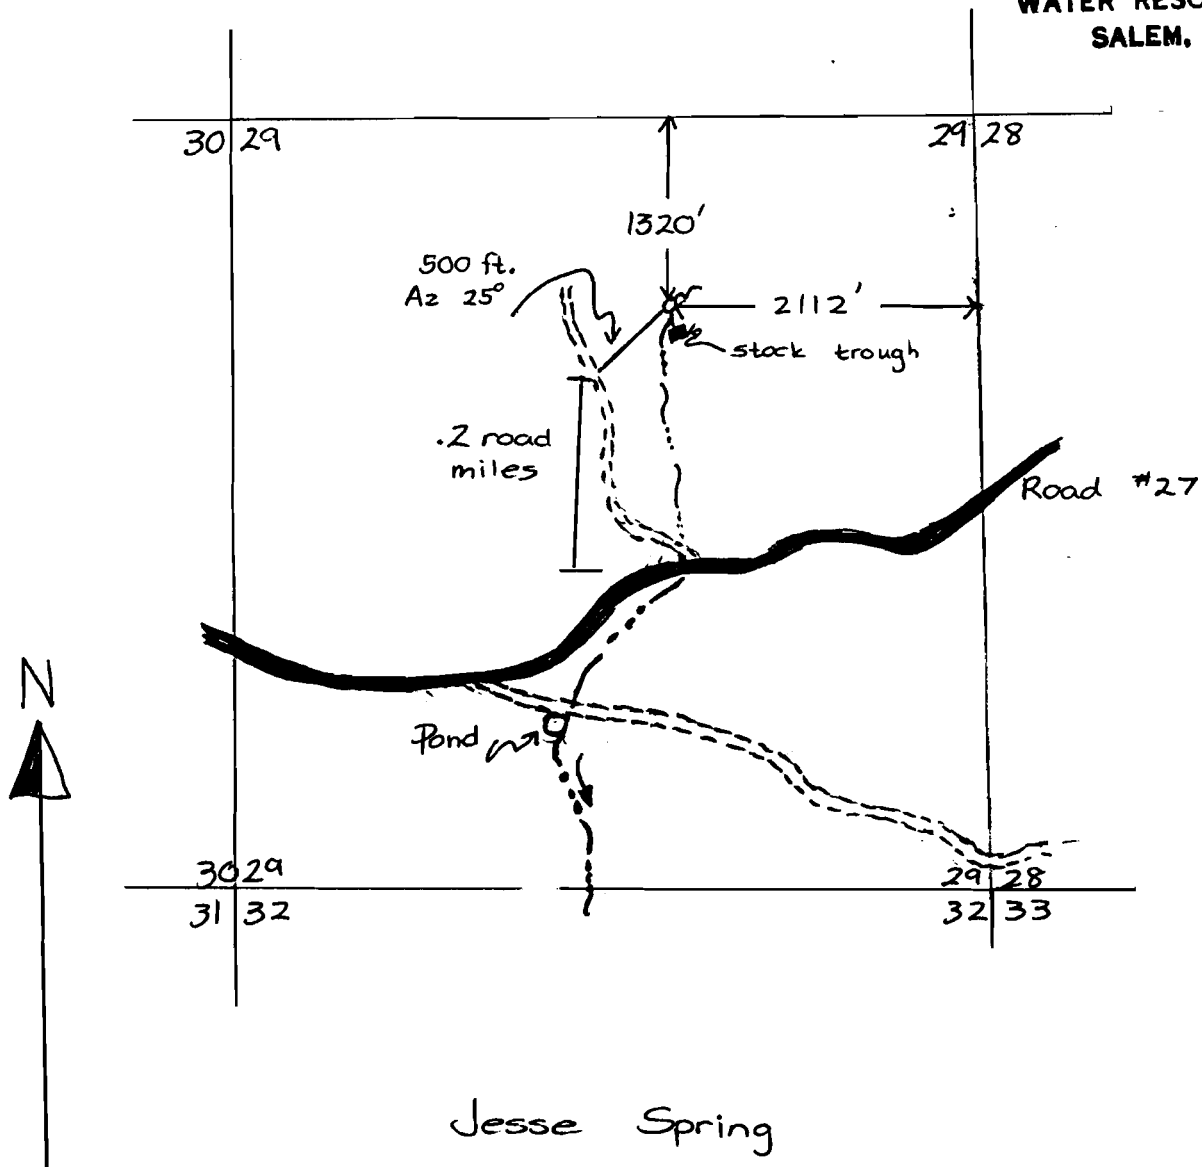

Jesse Spring

NW 1/4, NE 1/4, Sec. 29, T 12S., R 18E, W. M.

Scale: 4" = 1 mile

Application No. 62717

Permit No. 48650

cert. 63867

RECEIVED

DATE 2-28-90

WATER MASTER DISTRICT #11

BY SMD

48650