


RECEIVED


SEP 11 1981

WATER RESOURCES DEPT
SALEM, OREGON

KIDNAP SPRINGS

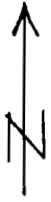

Aug. 1981
T. BEDORTHA

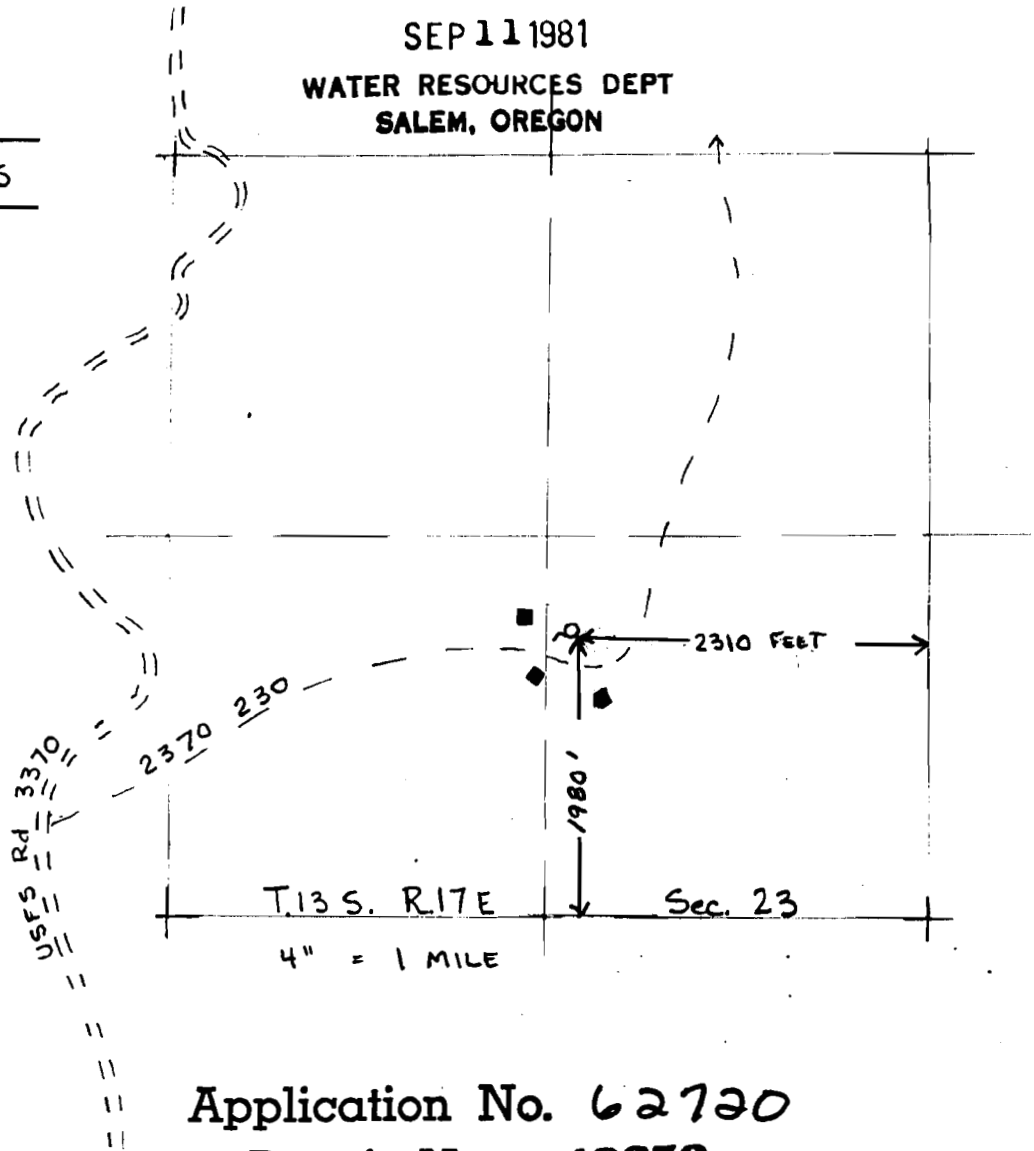


Application No. 62720


Permit No. 48653

Cut 63868

Spring development

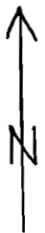

0 10 20 30 40 50 FEET

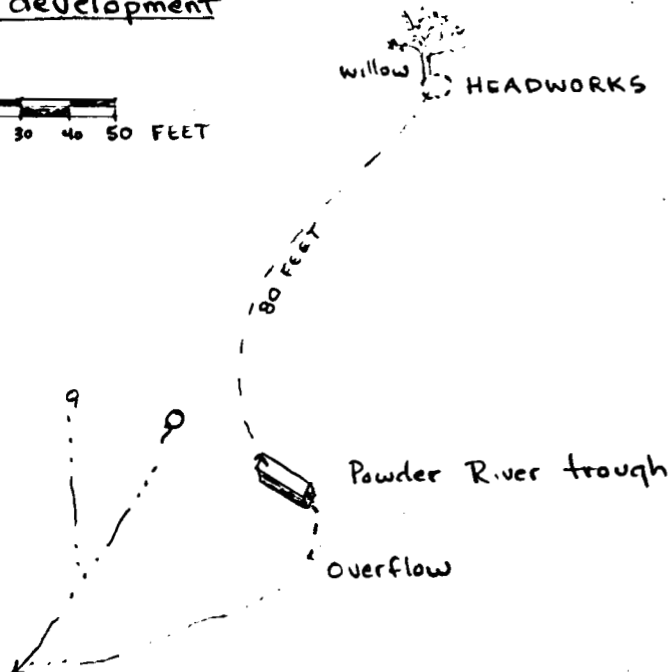

RECEIVED

DATE 2-28-90
WATER MASTER DISTRICT #11
BY SMJ

C-63868

48653