


RECEIVED

SEP 11 1981

WATER RESOURCES DEPT
SALEM, OREGON

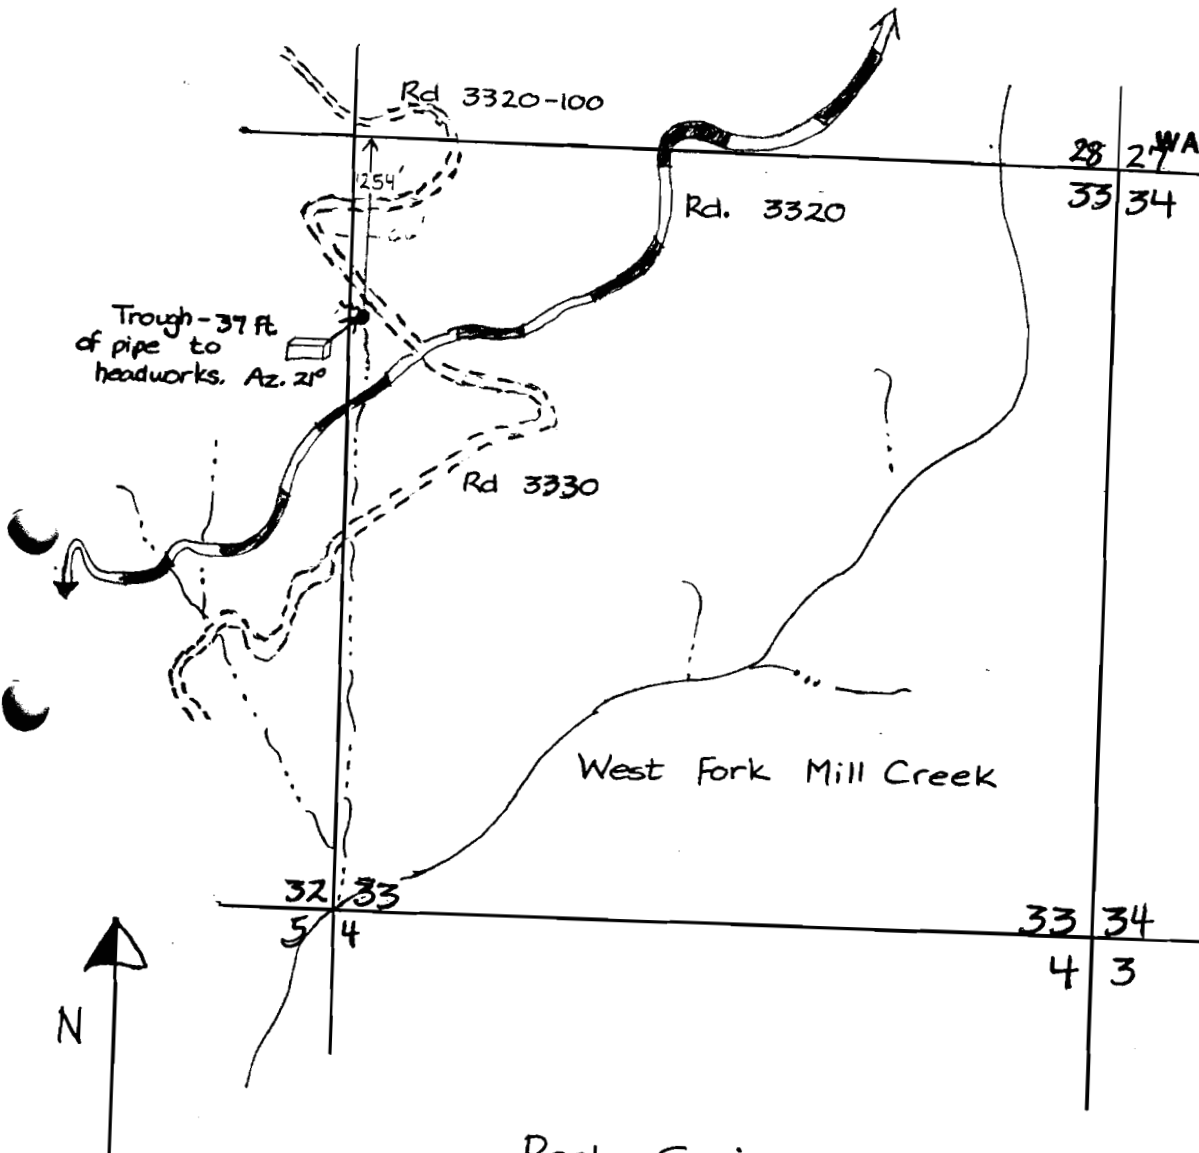

Rock Spring
NW $\frac{1}{4}$, NW $\frac{1}{4}$, Sec. 33, T 12S, R 18E, W.1M

Scale 4" = 1 mile

Application No. 62722

Permit No. 48655

cert. 63869

RECEIVED

DATE 2-28-90

WATER MASTER DISTRICT #11

BY SMD