
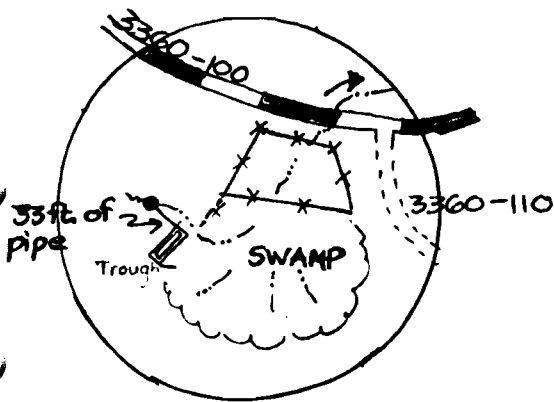


Scale 4" = 1 mile

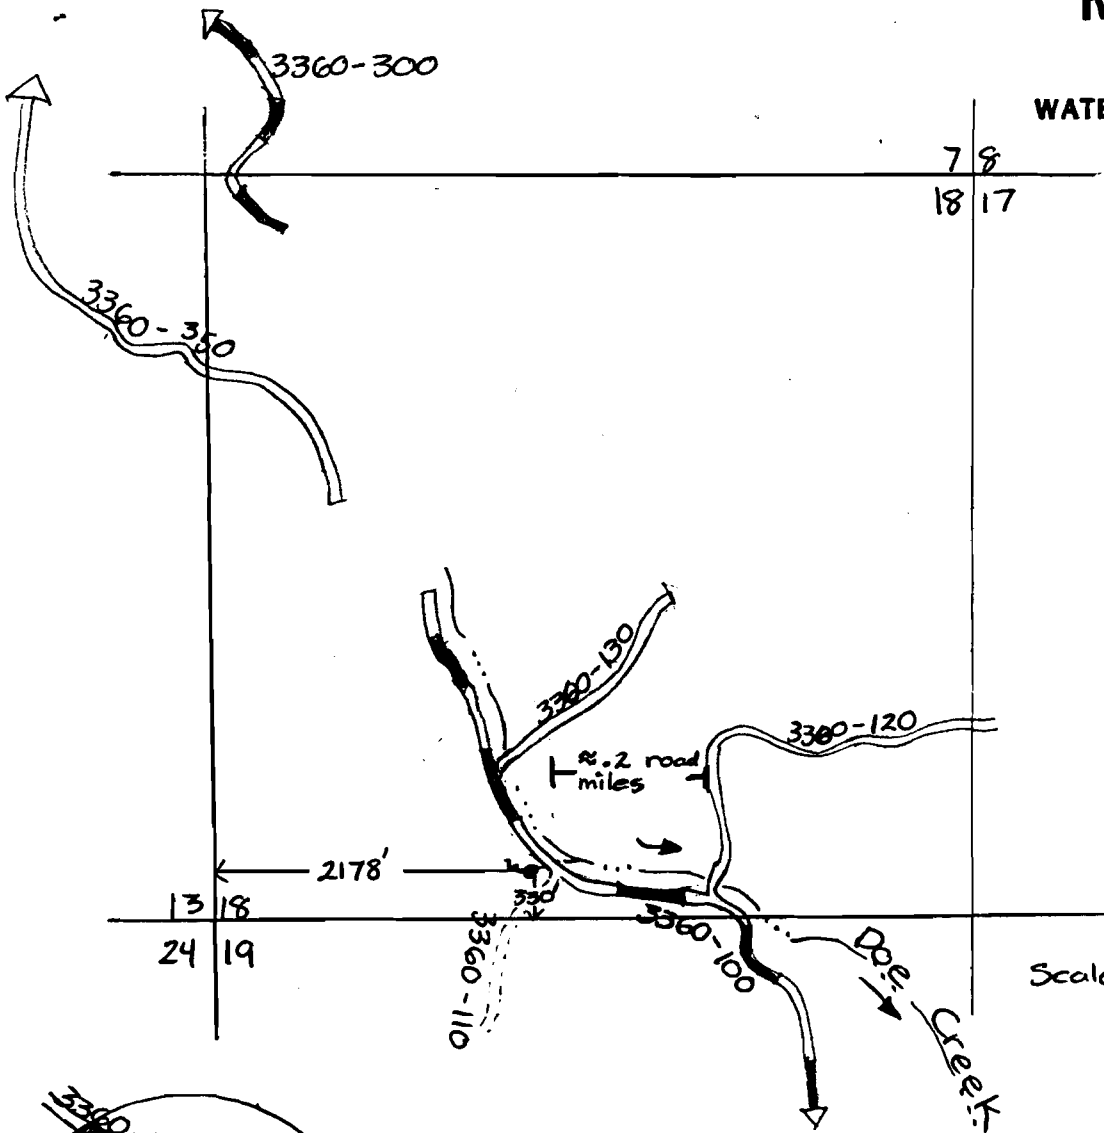

Upper Doe Spring

SE 1/4, SW 1/4 Sec. 18; T 13S, R 18E, W.M.

Application No. 62724
Permit No. 48657
cert. 63870

RECEIVED

DATE 2-28-90

WATER MASTER DISTRICT #11

BY SMO

48657