


RECEIVED

SEP 11 1981

WATER RESOURCES DEPT
SALEM, OREGON

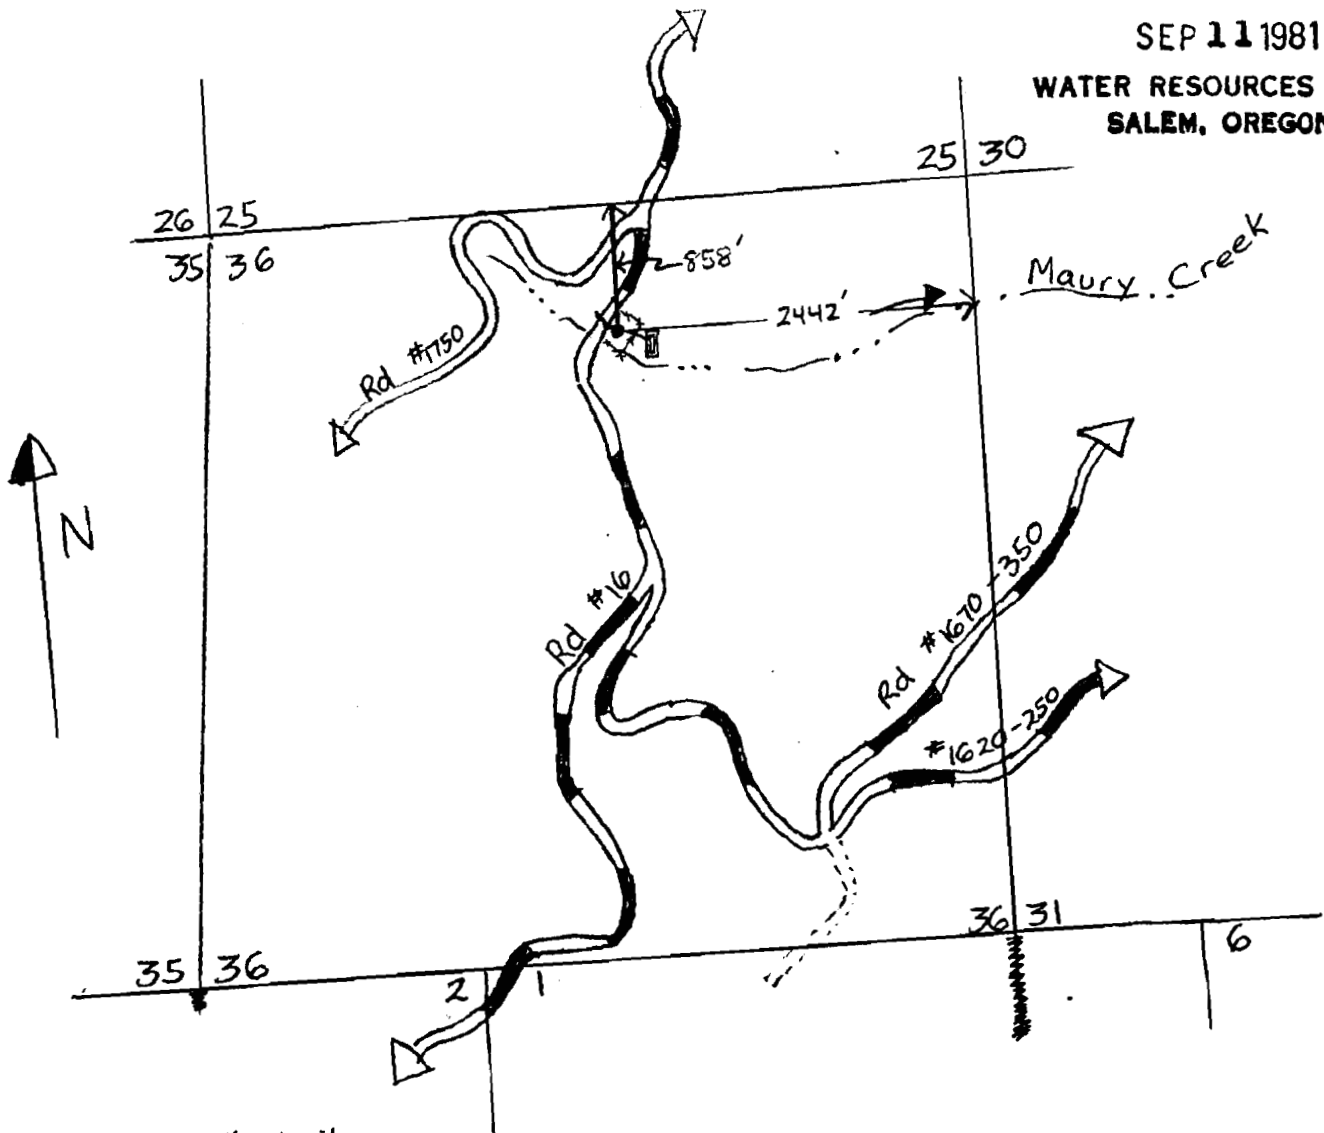

Scale 4" = 1 mile

Durham Spring

NW $\frac{1}{4}$, NE $\frac{1}{4}$, Sec. 36, T 17S, R 20E, W.M.

Application No. 62725

Permit No. 48658

Cert. 63871

RECEIVED

DATE 2-28-90

WATER MASTER DISTRICT #11

BY SMg

4865