
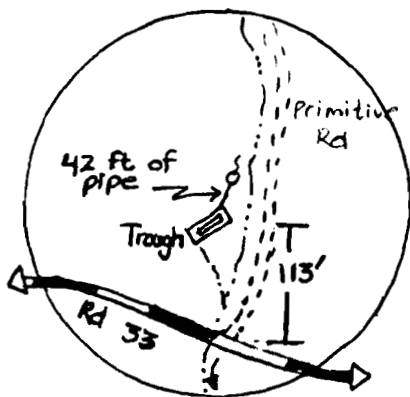


RECEIVED

SEP 11 1981

WATER RESOURCES DEPT
SALEM, OREGON

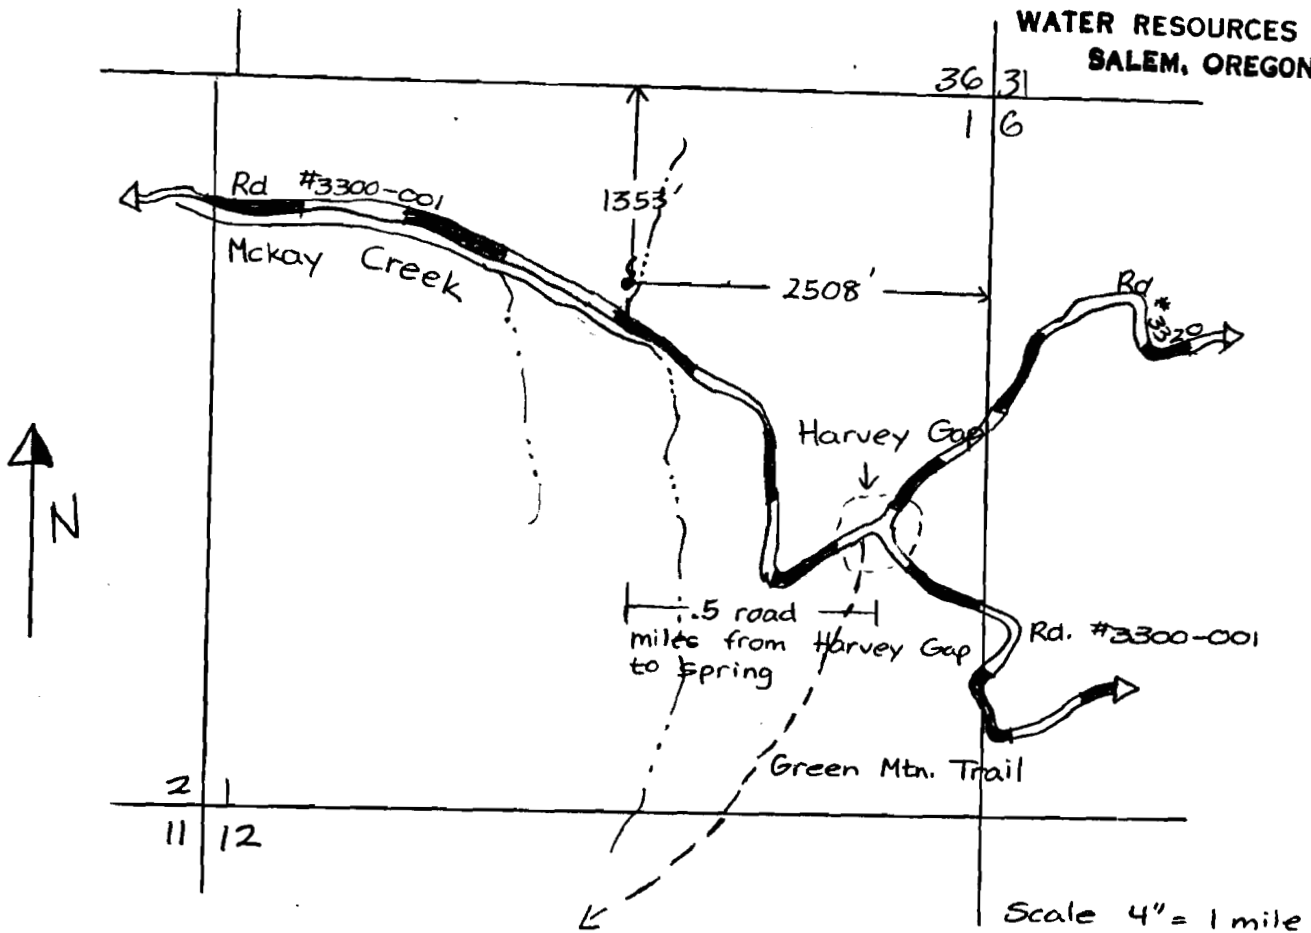

Harvey Spring
SW 1/4, NE 1/4, Sec. 6, T13S, R17E, W.M.

Application No. 62728

Permit No. 48661

Cert 63872

RECEIVED

DATE 2-28-90

WATER MASTER DISTRICT #11

BY SMY

48661