



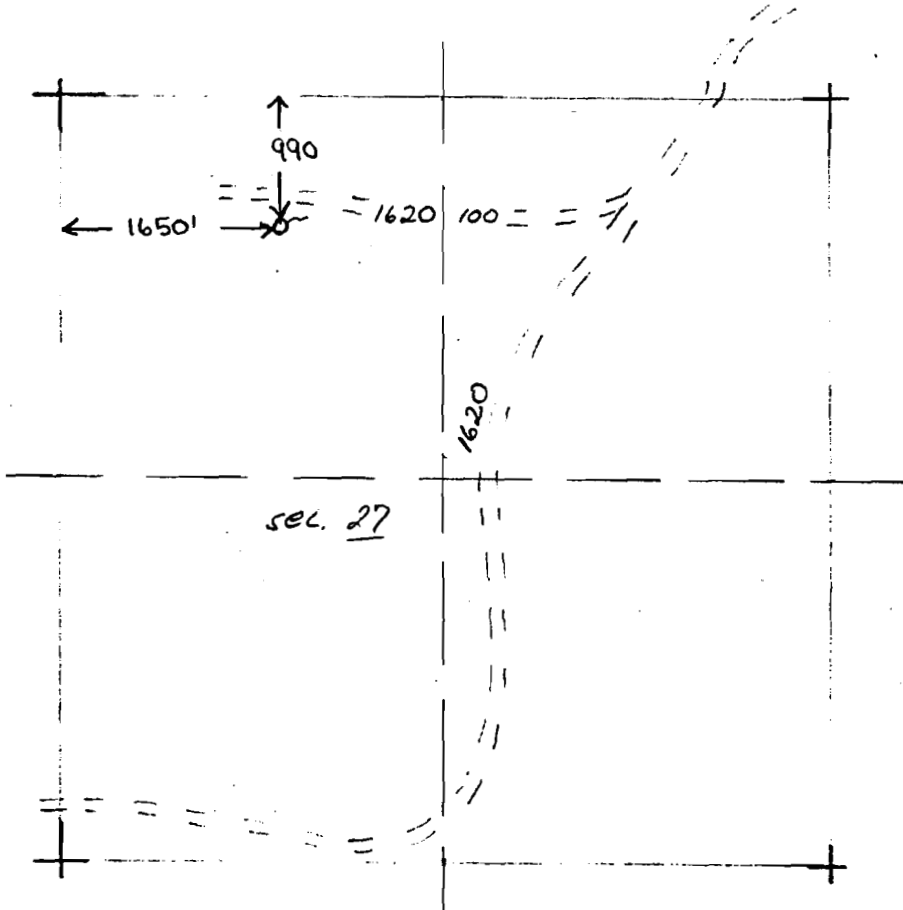

Bob Cat Spring

T. 17 S. R. 18 E. Sec 27

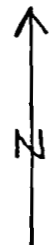

4" = 1 MILE


T. Bedortha
Aug. 1981

RECEIVED

SEP 11 1981

WATER RESOURCES DEPT
SALEM, OREGON

Spring development

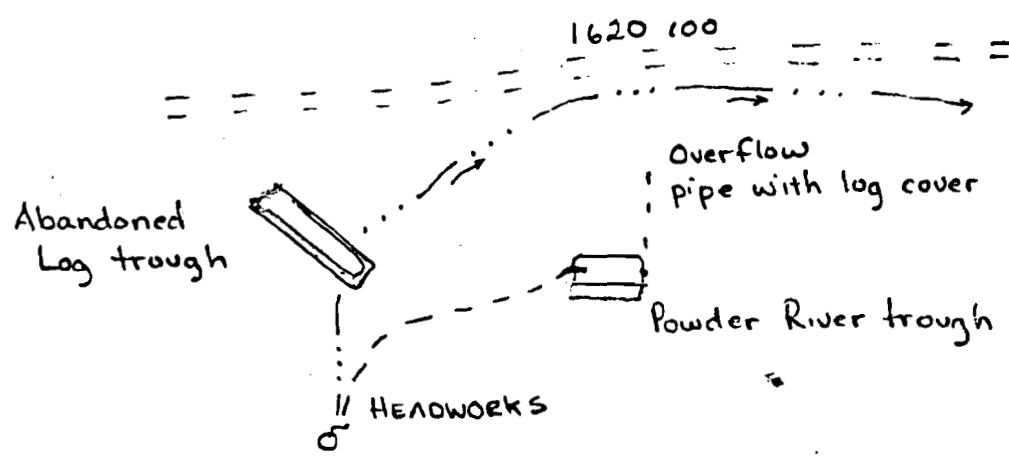


RECEIVED

DATE 2-28-90

WATER MASTER DISTRICT #11

BY *gmd*

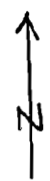

0 10 20 30 40 50 FEET

Application No. 62729

Permit No. 48662

cert. 63873

48662