


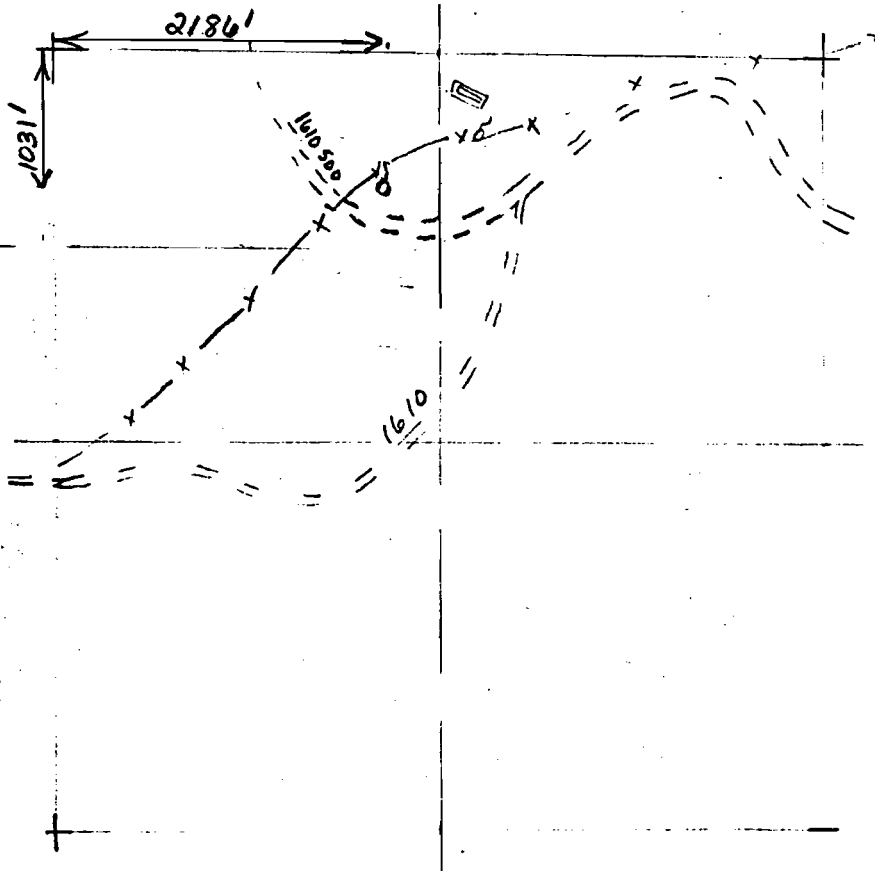

Gibson Spring

T. 17 S. R. 18 E. Sec 34

4" = 1 MILE

T. Bedortha
Aug 81

Application No. 62730

Permit No. 48663

Cert. 63874


Spring development

Log trough
(active)

RECEIVED

SEP 11 1981

WATER RESOURCES DEPT.
SALEM, OREGON

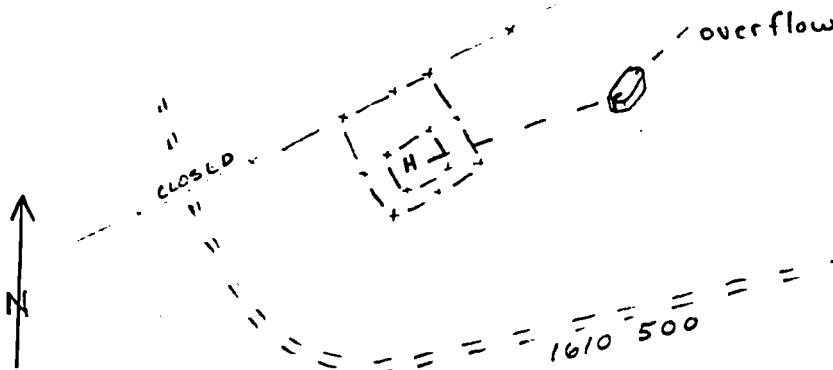

RECEIVED

AUG 24 1983

WATER RESOURCES DEPT.
SALEM, OREGON

0 10 20 30 40 FEET

RECEIVED

DATE 2-28-90

WATER MASTER DISTRICT #11

BY SMS

C-63874

48663