


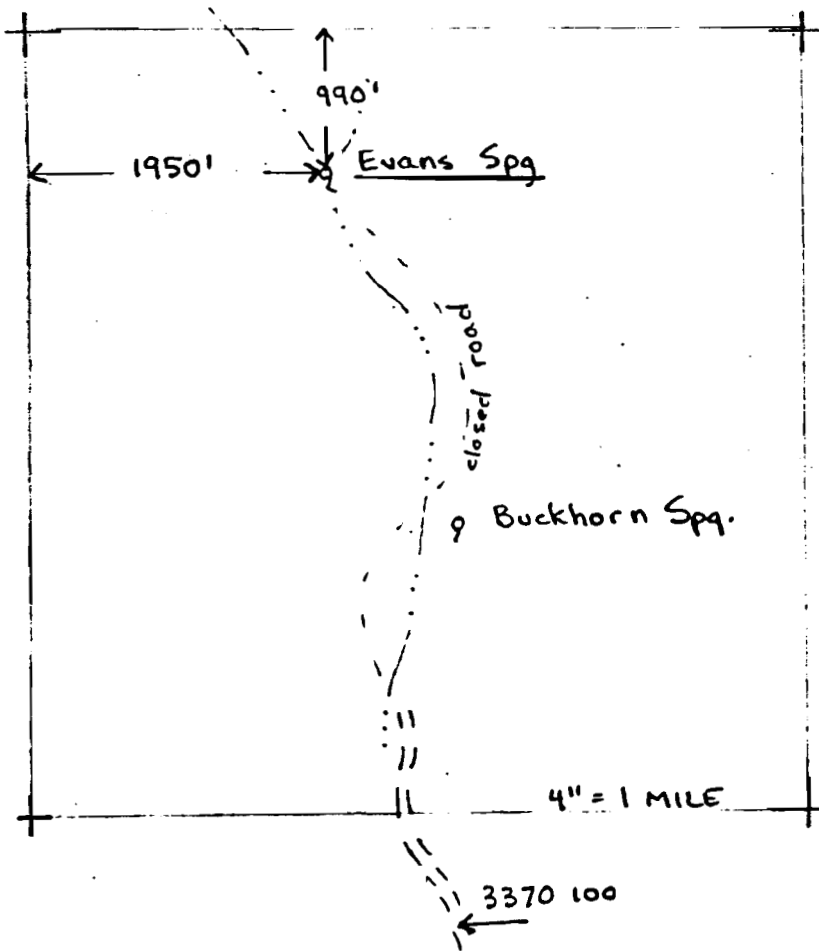



Evans Spring
T. 13 S., R. 17 E., Sec. 21

↑
 N
 T. Bedortha
 Aug. 1981

RECEIVED
 SEP 11 1981
 WATER RESOURCES DEPT
 SALEM, OREGON

Spring development

Application No. **62732**
 Permit No. **48665**
 Cert. 63876

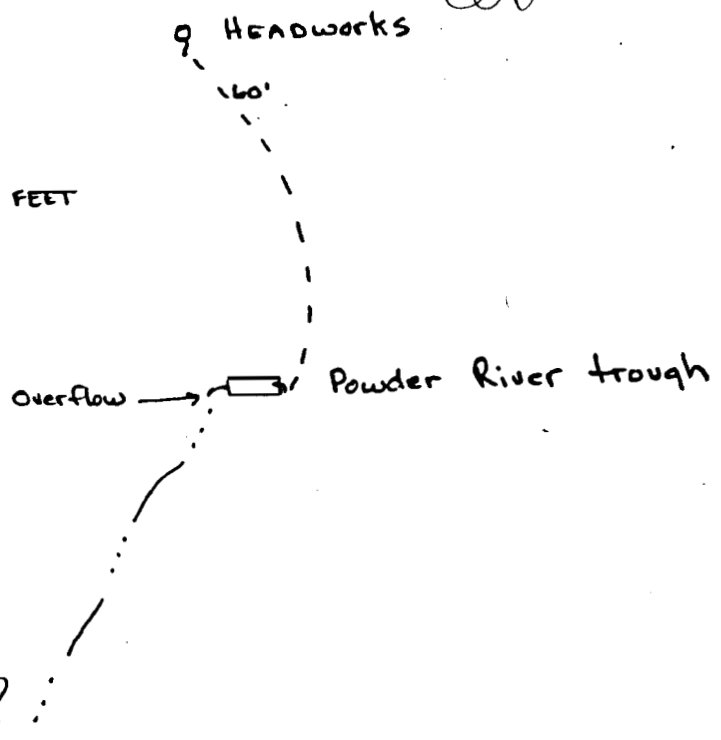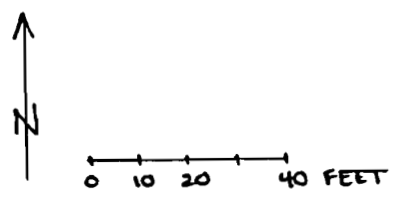

RECEIVED

DATE 2-28-90
 WATER MASTER DISTRICT #11
 BY SMJ

48665