


RECEIVED

SEP 11 1981

WATER RESOURCES DEPT
SALEM, OREGON

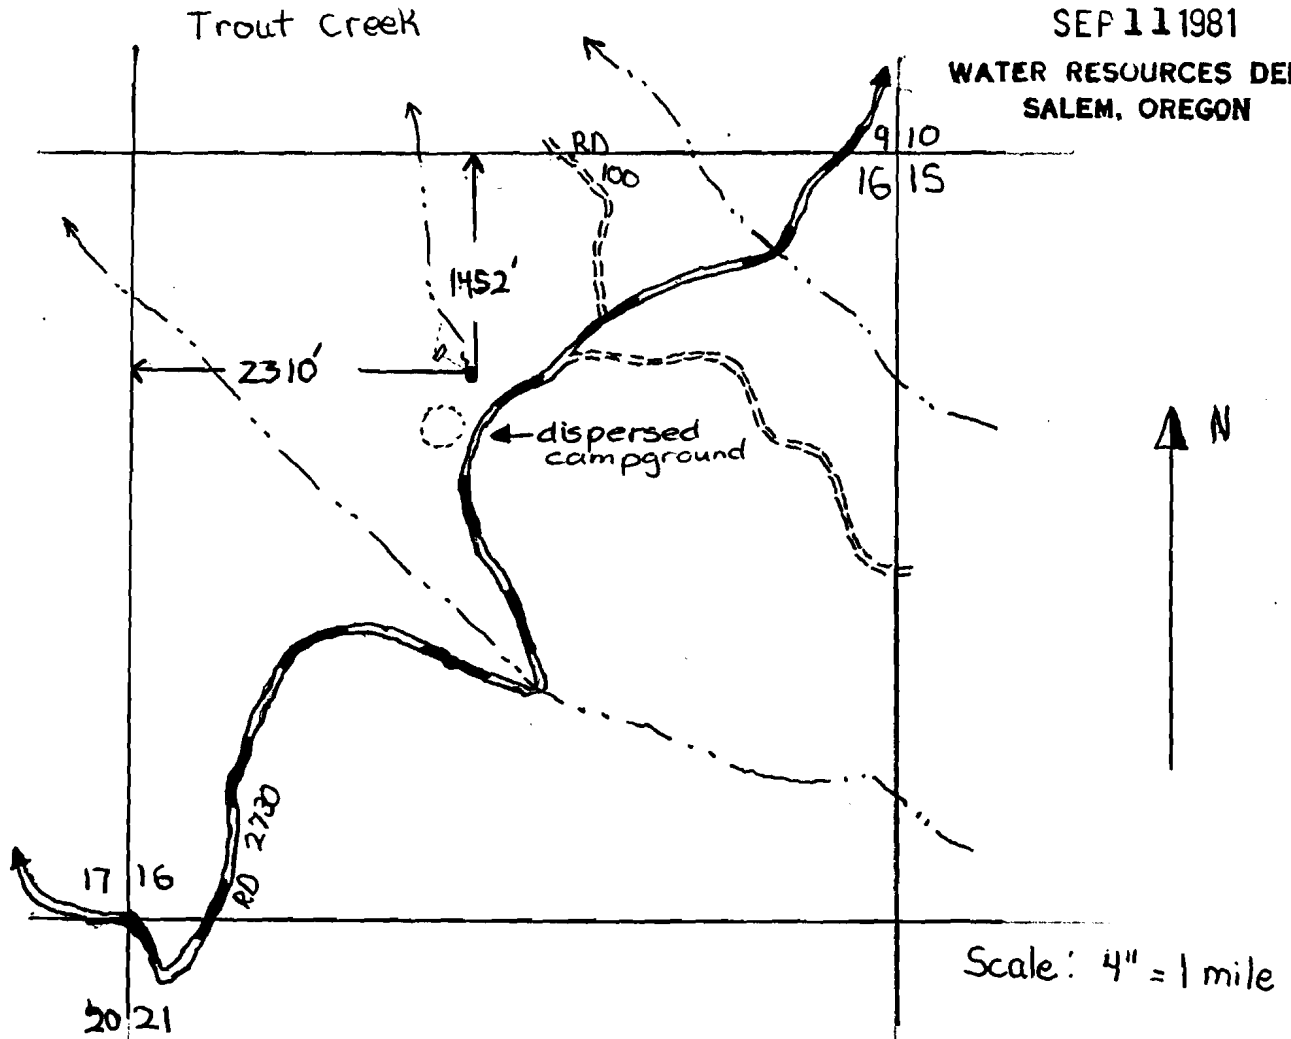


RECEIVED

DATE 2-28-90

WATER MASTER DISTRICT #11

BY SMJ

Cougar Spring
T. 12 S R 18 E Sec 16 SE 1/4 NW 1/4

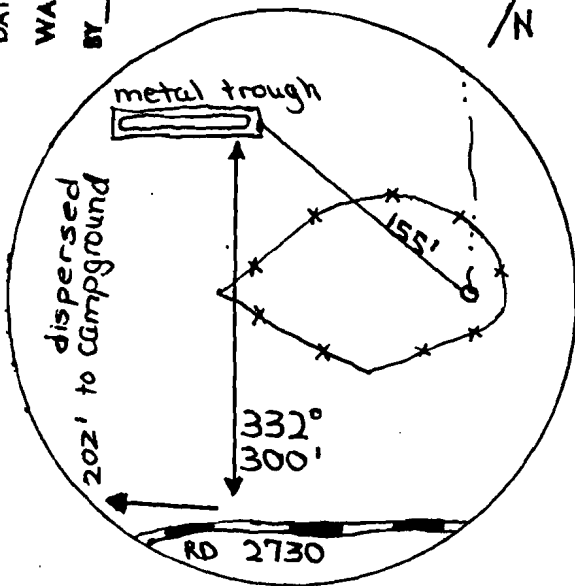

Application No. 62735
Permit No. 48668

cert. 63877

48668