


RECEIVED

SEP 11 1981

WATER RESOURCES DEPT
SALEM, OREGON

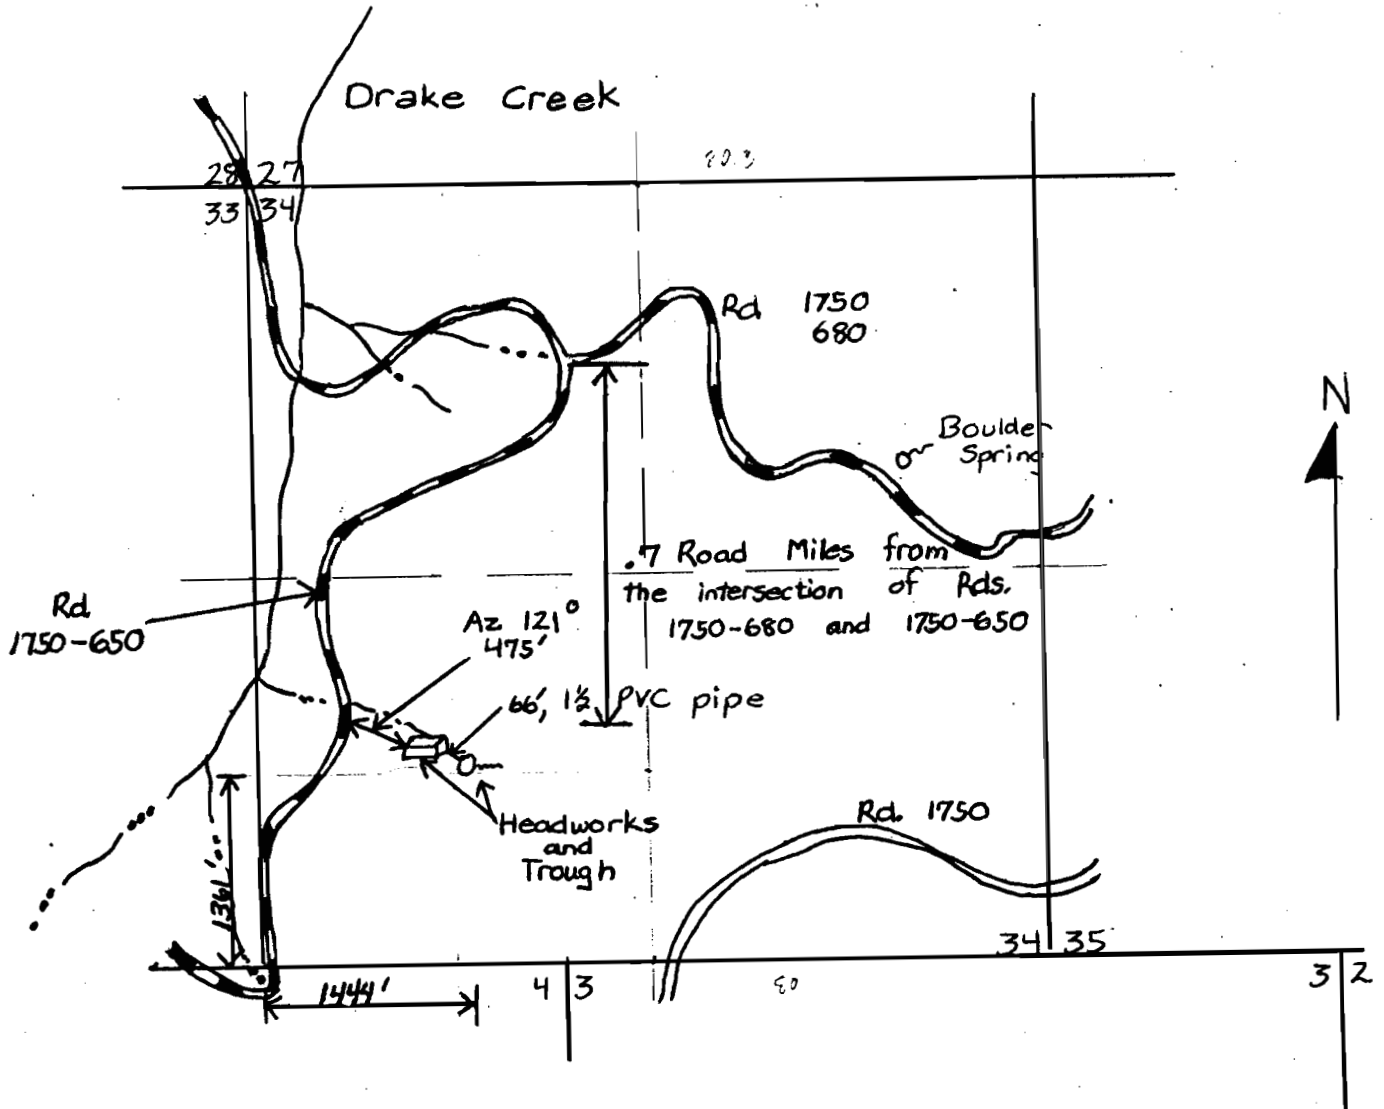

WIDOW-MAKER SPRING

NW 1/4, SW 1/4, Sec. 34, T 17S, R 20E, W. M.

Scale:
4" = 1 mile

Application No. 62739

Permit No. 48672

Cert. 63878

RECEIVED

DATE 2-28-90

WATER MASTER DISTRICT #11

BY SMY

48672