


RECEIVED

SEP 11 1981

WATER RESOURCES DEPT
SALEM, OREGON

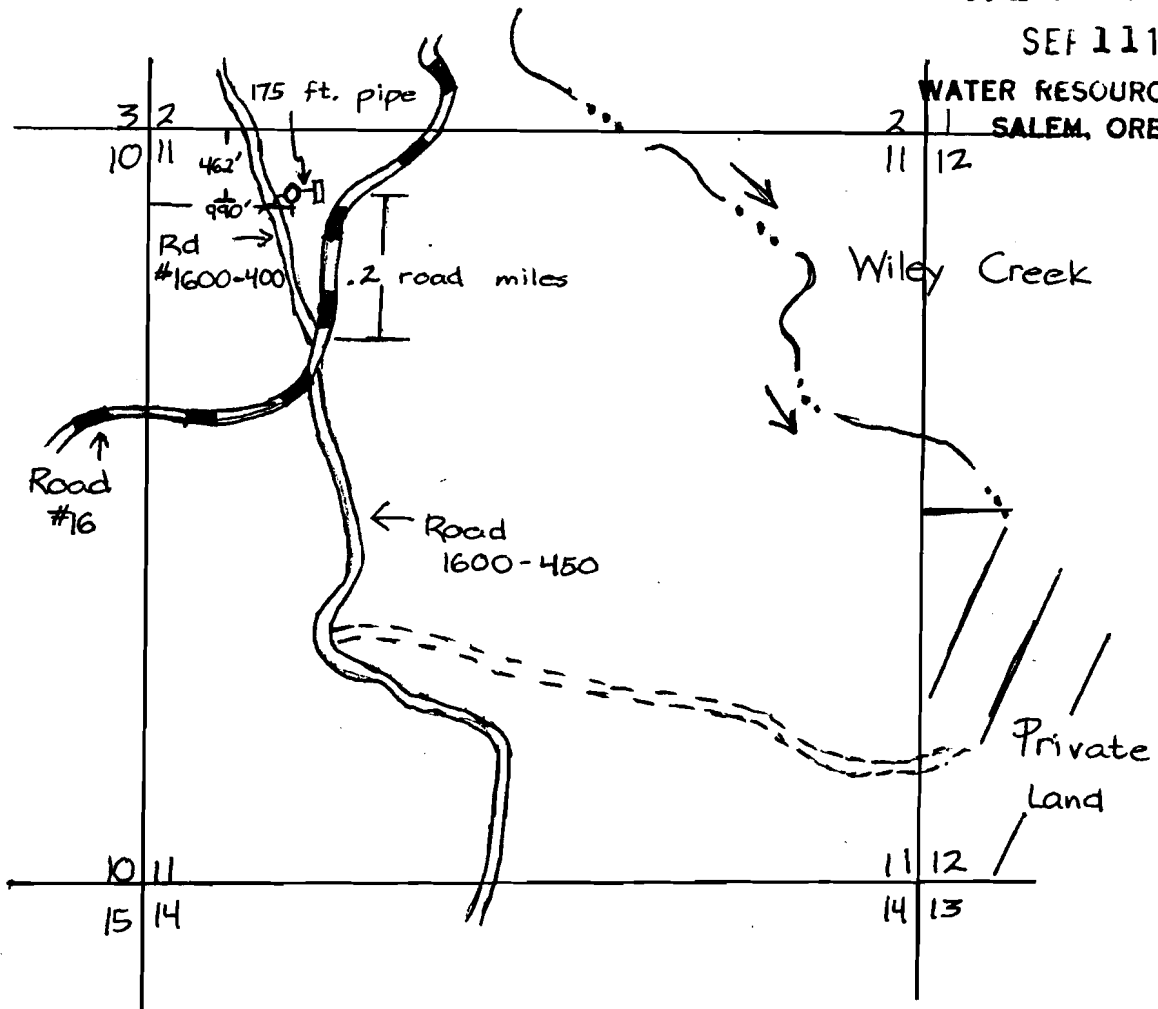

J.F. Spring

NW¹/₄, NW¹/₄, Sec. 11, T18S, R20E, W.M.

Scale: 4" = 1 mile

Application No. 62740

Permit No. 48673

Cert. 63879

RECEIVED

DATE 2-28-90
WATER MASTER DISTRICT #11
BY *SMJ*

48673