

SEP 11 1981

RECEIVED


DATE 2-28-90

WATER MASTER DISTRICT #11

BY smg


Slayton Spring

T. 13 S. R. 17 E. Sec. 32

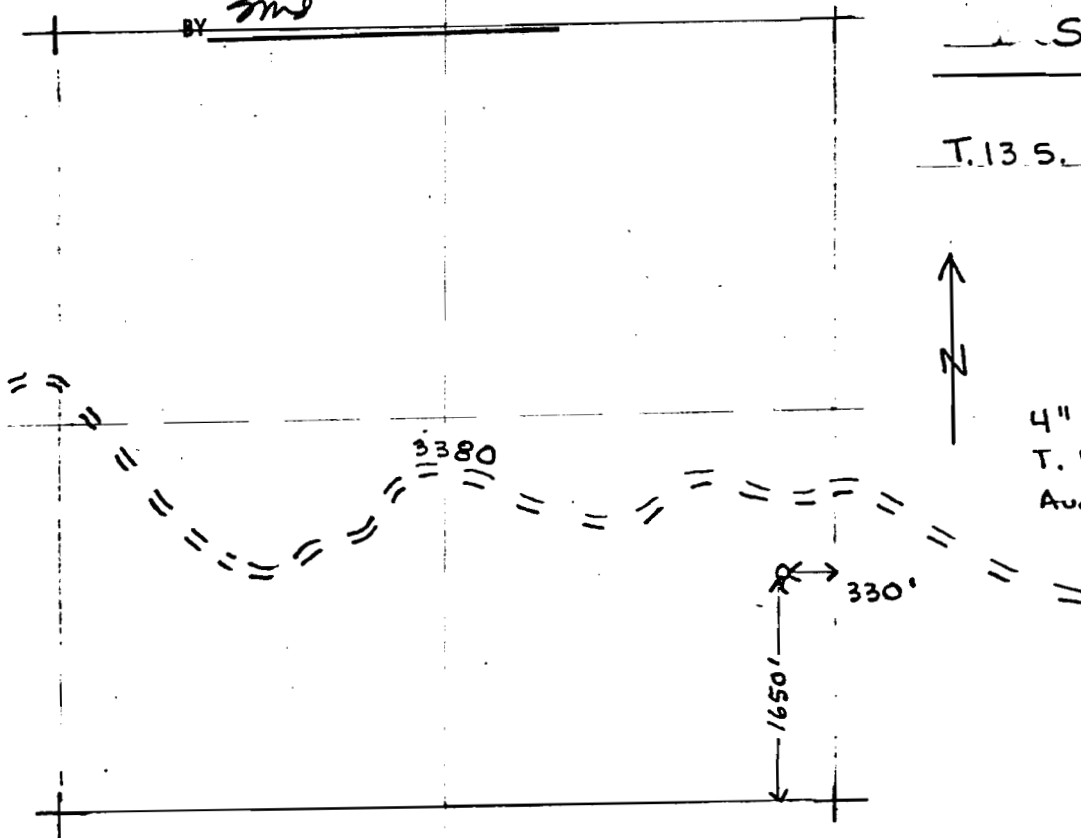

4" = 1 MILE
T. Bedortha
Aug. 1981

Spring development

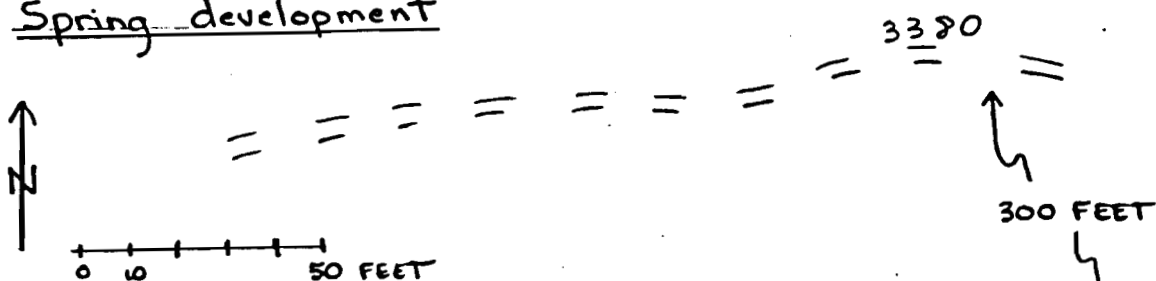

Permit No. 48675

cert. 63880

overflow

HEADWORKS

Powder River
trough

C-63880
48675