


RECEIVED

SEP 11 1981

WATER RESOURCES DEPT
SALEM, OREGON

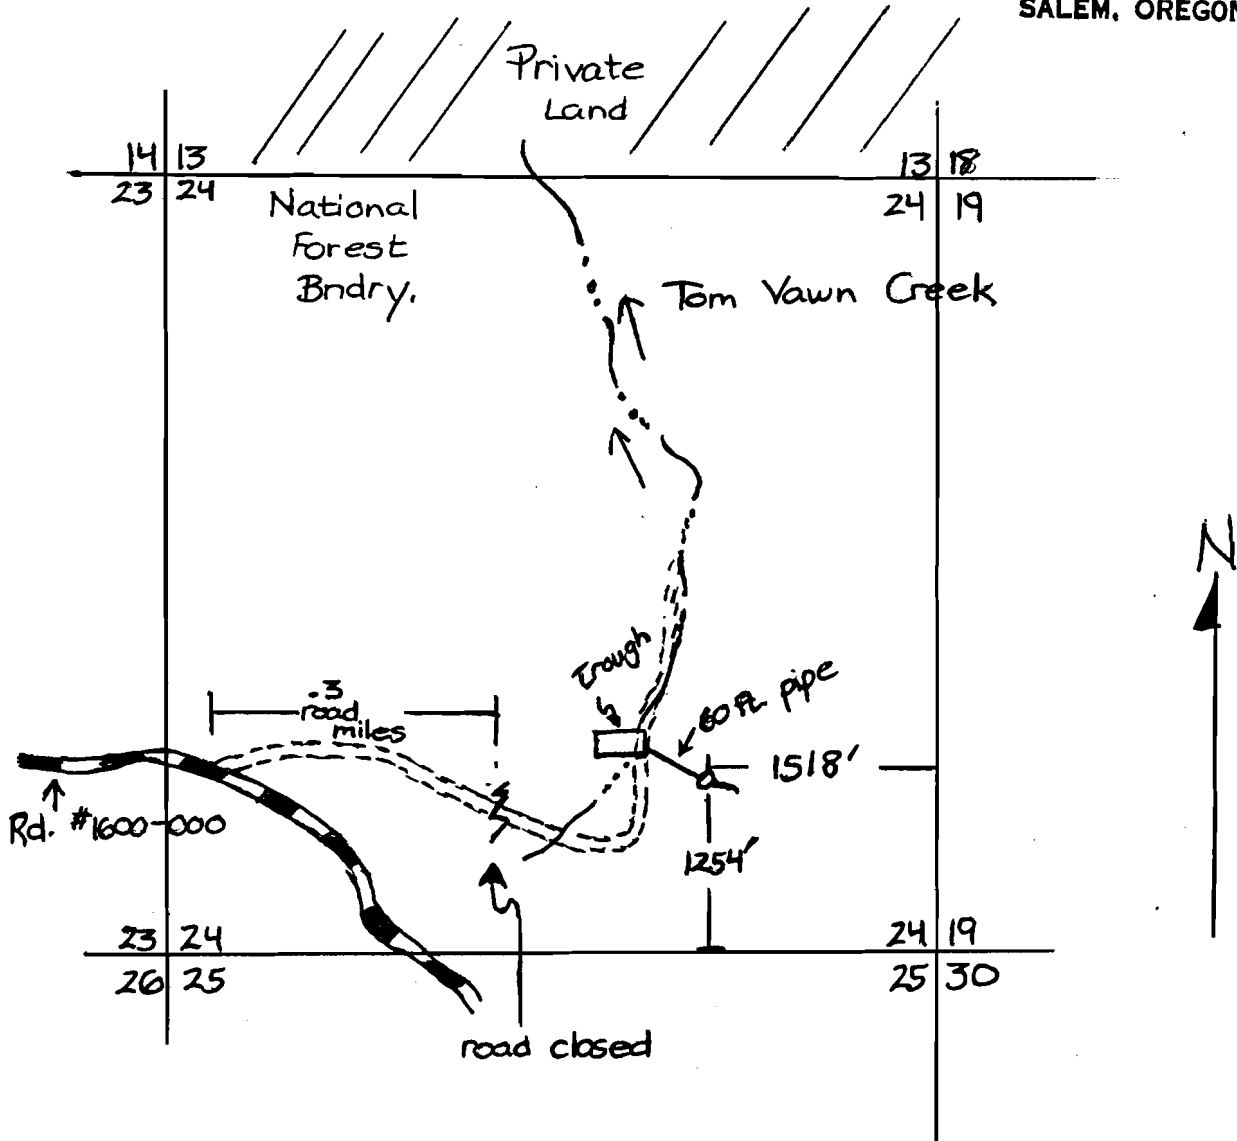

Tom Vawn Spring

SW $\frac{1}{4}$, SE $\frac{1}{4}$, Sec. 24, T17S, R20E, W.M.

Scale: 4" = 1 mile

Application No. 62743

Permit No. 48676

Cert. 63881

RECEIVED

DATE 2-28-90

WATER MASTER DISTRICT #11

BY JMJ

C-63881

48676