


RECEIVED
SEP 11 1981
WATER RESOURCES DEPT
SALEM, OREGON

Gulliford Spring

T. 13 S. R. 17 E. Sec. 29

29

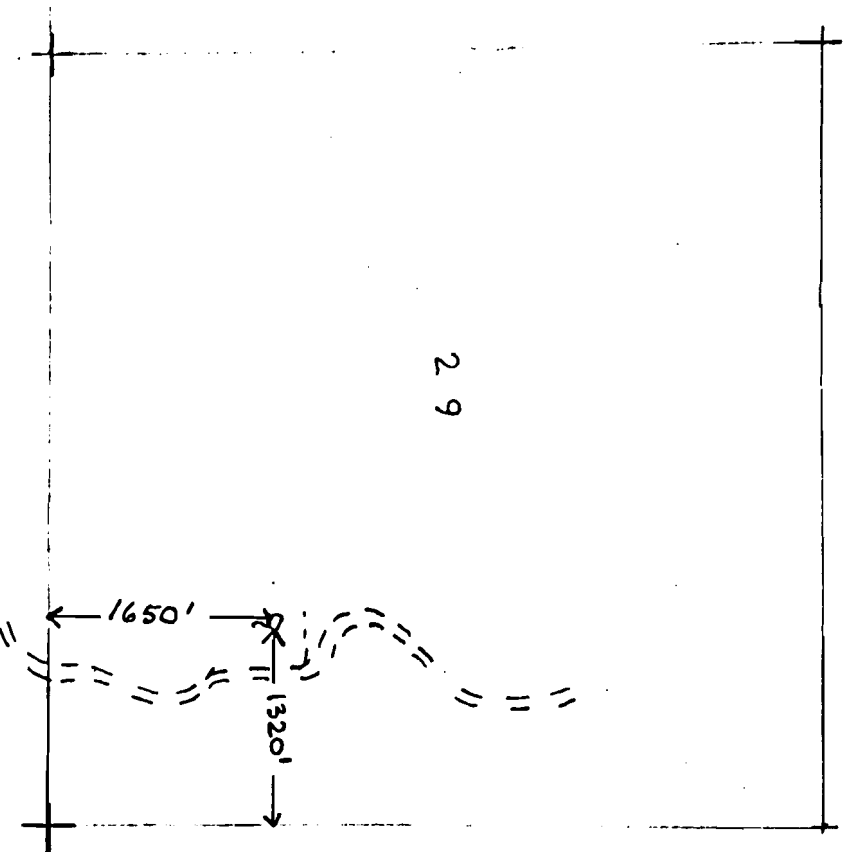


4" = 1 MILE
T. Bedortha
Aug. 1981


Spring development

Application No. 62745
Permit No. 48678

Cert. 63882

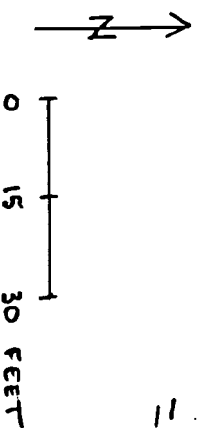

Rouder River
trough

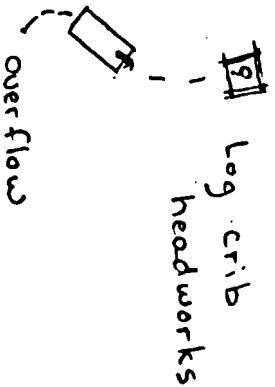

RECEIVED
DATE 2-28-90
WATER MASTER DISTRICT #11
BY SW

48678