


RECEIVED

MAR 25 1983

WATER RESOURCES DEPT.
SALEM, OREGON

Application No. 63911
Permit No. 48685

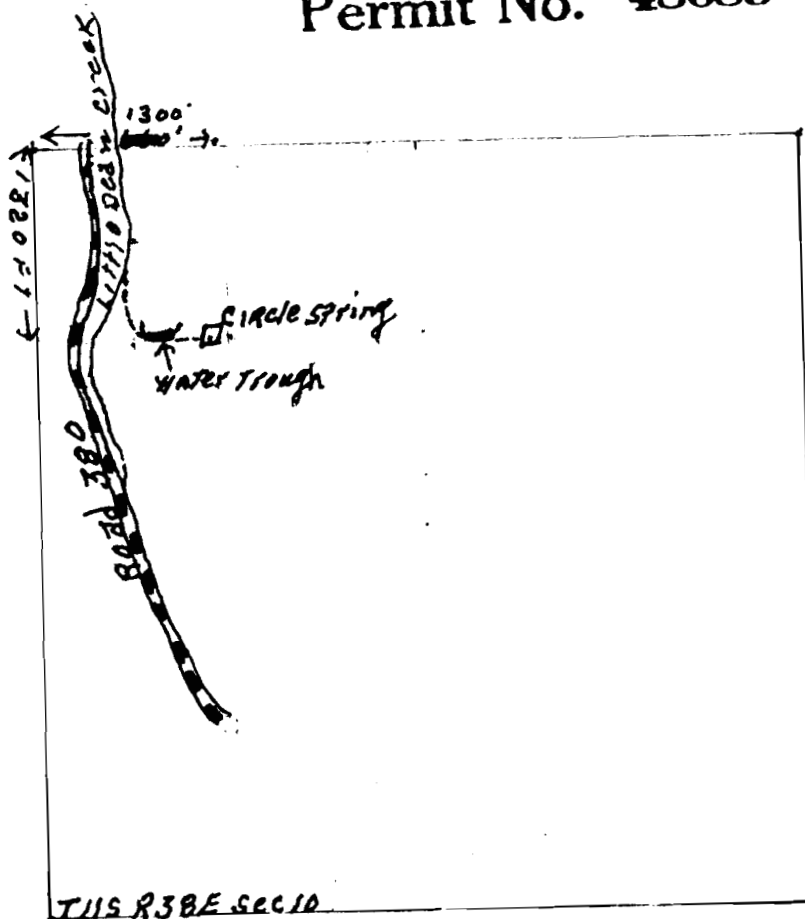

RECEIVED

AUG 23 1982

WATER RESOURCES DEPT.
SALEM, OREGON

RECEIVED

APR 29 1983

WATER RESOURCES DEPT.
SALEM, OREGON